IREDELL COUNTY HEALTH DEPARTMENT

STATESVILLE 704-878-5305 MOORESVILLE 704-664-5281

IMPROVEMENT PERMIT / CERTIFICATE OF COMPLETION / OPERATION PERMIT / EXISTING SYSTEM INSPECTION

PROPERTY DESCRIPTION NO. 20828 DATE 8/13/95 TAX MAP NO. 1C 9A 13 4654993423 Watershed: ☐ Yes ☒ No

OWNER OR CONTRACTOR ~~Bobby Hutton~~ RONNIE HAGAR PHONE: Business _____ Home 892-0223

ADDRESS Barrack Rd. ~~Mooresville~~ NC. 28115

LOCATION Midway Lake Rd. TR Barrack Rd. 1st end last drive on (R) to lower house

SUBDIVISION Barrack Pl BLOCK / SECTION 1 LOT 13 LOT AREA 6.5AC SITE CLASS. PS DESIGN FLOW 360 L.T.A.R. .3 (SHALLOW)

Septic Tank: 1000 Gallons; STB 794 Date 10/8/97

Pump Tank: 1000 Gallons; PT 27 Date 11/19/97

Pump Make: GOULDS Model WE05 IIH Serial No. H9746088

Nitrification Field: No Fields 1 Square Feet 1200 Linear Feet 400

No Lines 3 Trench Width 36" Max Trench Bottom Depth 24" Gravel Depth 12"

☒ New System ☐ Repair System Type: I, II, (III) IV, V, VI

System Description: SHALLOW - PRES. CONVENTIONAL

Repair System Description: PRESSURE - CONV.

Maintenance Agreement Required: ☒ Yes ☐ No

☒ House/Mod. Home ☐ Mobile Home ☐ Business ☐ Other

No. Bedrooms 3 No. Bathrooms 3 No. Employees ____


☐ Slab ☒ Crawl Space ☐ Basement w/plumbing ☐ Basement wo/plumbing

Water Supply: ☒ Individual ☐ Community ☐ Public


Comments: Shallow pressure conventional w/ pressure manifold

Comments:

INITIAL SITE SKETCH

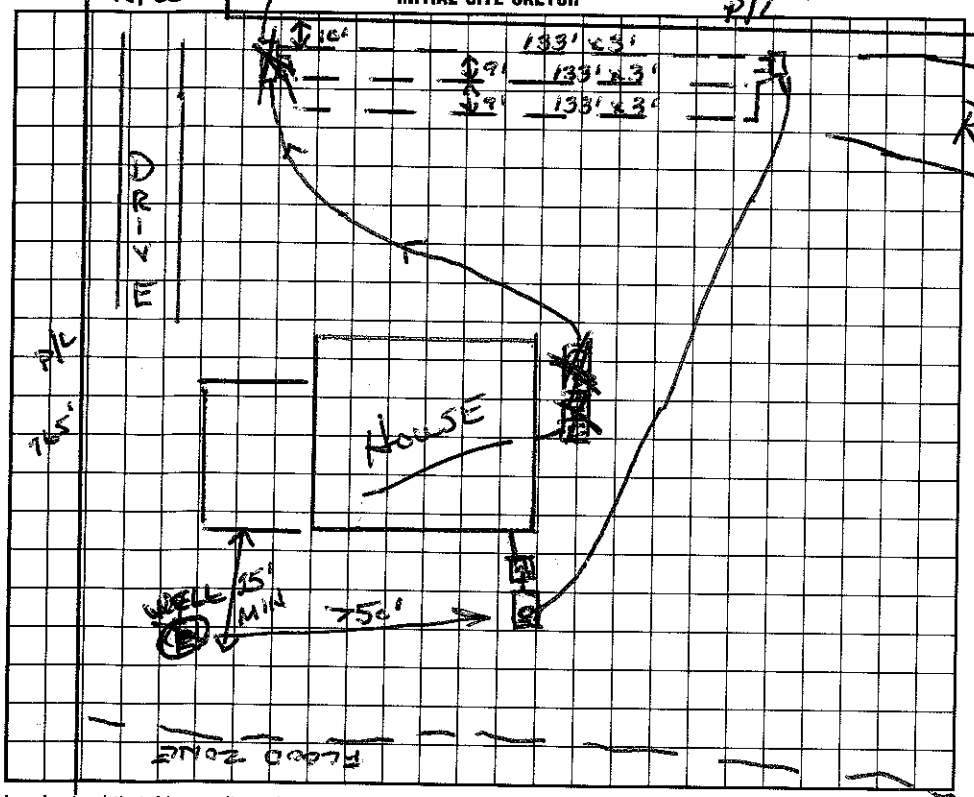

AS BUILT SKETCH

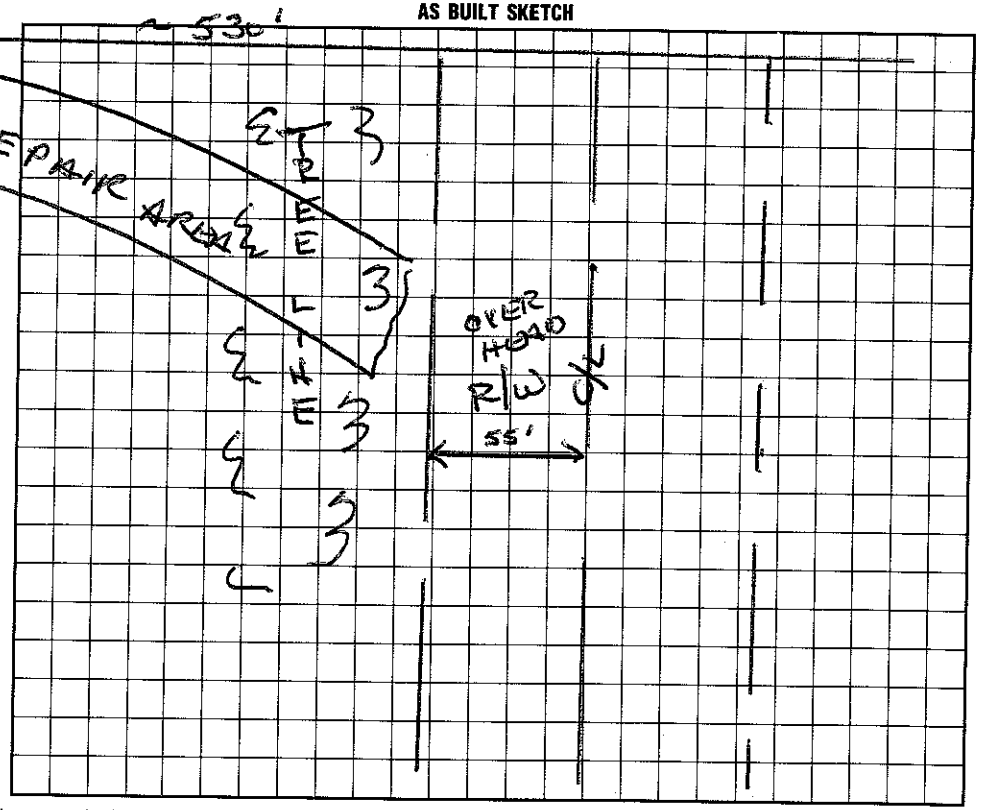

I understand that this permit can be suspended or revoked if any false information is supplied toward securing the permit, any unauthorized changes are made to the site/any unauthorized changes are made in the installation of the system.

Signed: R S Allen

Improvement Permit by: Wesley Sparks R.S. date 8/13/95

Existing System Inspection by: _____ date _____

Installed by: F J Ervin

Certificate of Completion by: Wesley Sparks LS date 1/30/98

Operation Permit by: Wesley Sparks R.S. date 1/30/98

HEALTH DEPT. COPY: WHITE INSPECTION COPY (FINAL): GREEN OWNER COPY (FINAL): YELLOW INSPECTION COPY (INITIAL): PINK OWNER COPY (INITIAL): GOLD