~~466~~ 4655048194

IREDELL COUNTY HEALTH DEPARTMENT

STATESVILLE 704-878-5305 MOORESVILLE 704-664-5281

IMPROVEMENT PERMIT / CERTIFICATE OF COMPLETION / OPERATION PERMIT / EXISTING SYSTEM INSPECTION

PROPERTY DESCRIPTION NO. Repair DATE 11/9/94 TAX MAP NO. Repair Watershed: ☐ Yes ☑ No

OWNER OR CONTRACTOR Betty D. Howard PHONE: Business _____ Home 892-3483

ADDRESS 1671 Mecklenburg Hwy Mooresville, NC.

LOCATION 4th house on L before Butler Rooney

SUBDIVISION N/A BLOCK / SECTION _____ LOT _____ LOT AREA Existing SITE CLASS. I DESIGN FLOW 240 L.T.A.R. .25 - .3

Septic Tank: Existing Gallons; STB _____ Date _____

Pump Tank: _____ Gallons; PT _____ Date _____

Pump Make: _____ Model _____ Serial No. _____

Nitrification Field: No Fields 1 Square Feet 810 Linear Feet 270

No Lines 3 Trench Width 36" Max Trench Bottom Depth 36" Gravel Depth 12"

☐ New System ☑ Repair System Type: I, (II), III, IV, V, VI

System Description: CONV - DIST. BOX

Repair System Description: _____

Maintenance Agreement Required: ☐ Yes ☑ No

☑ House/Mod. Home No. Bedrooms 2

☐ Mobile Home No. Bathrooms 1

☐ Business No. Employees ____

☐ Other _____


☐ Slab ☑ Crawl Space ☐ Basement w/plumbing ☐ Basement wo/plumbing

Water Supply: ☑ Individual ☐ Community ☐ Public

Comments: Keep trenches shallow as possible in area

Comments: Installed as shown on Imp. Permit

INITIAL SITE SKETCH

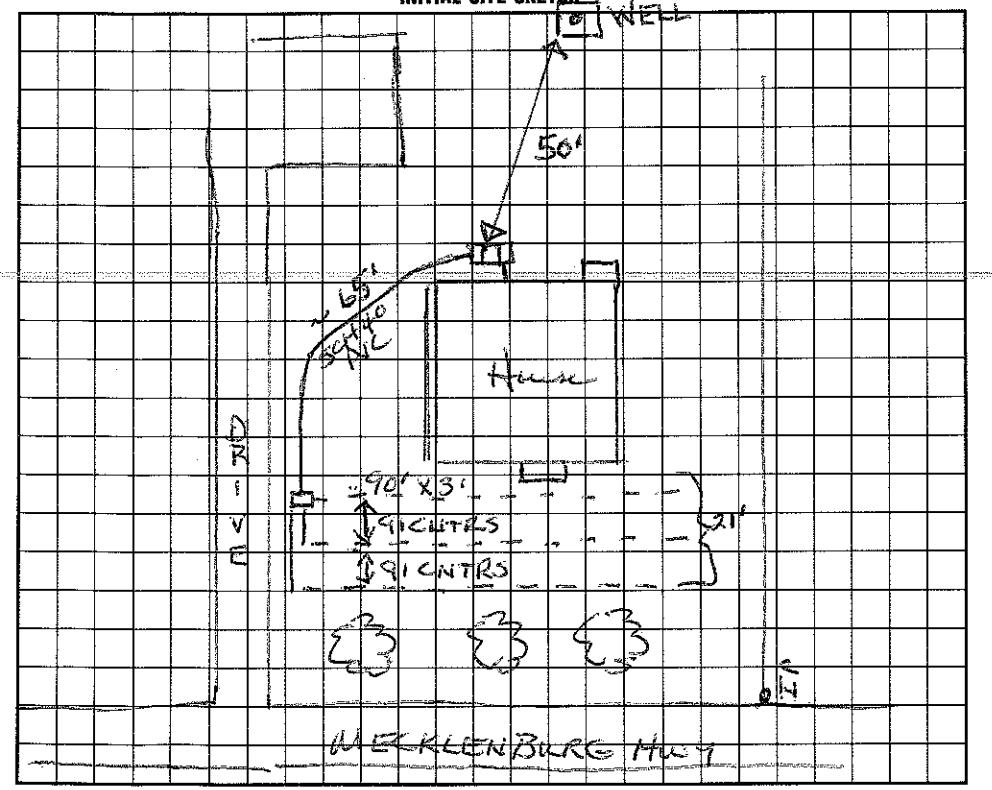

AS BUILT SKETCH

I understand that this permit can be suspended or revoked if any false information is supplied toward securing the permit/any unauthorized changes are made to the site/any unauthorized changes are made in the installation of the system. Improvement Permit is valid for 60 months from date of issuance.

Signed: _____

Improvement Permit by: Wesley Sparks RS. date 11/9/94

Existing System Inspection by: _____ date _____

Installed by: T W Simmons

Certificate of Completion by: Wesley Sparks RS. date 11/15/94

Operation Permit by: _____ date _____

HEALTH DEPT. COPY: WHITE INSPECTION COPY (FINAL): GREEN OWNER COPY (FINAL): YELLOW INSPECTION COPY (INITIAL): PINK OWNER COPY (INITIAL): GOLD