authorization to Construct 4655056275

STATESVILLE 704-878-5305 MOORESVILLE 704-664-5281

~~CERTIFICATE OF COMPLETION /~~ OPERATION PERMIT / EXISTING SYSTEM INSPECTION

22 117 DATE 10/10/95 TAX MAP NO. 2H 19 A 21 Watershed: ☐ Yes ☒ No

OWNER OR CONTRACTOR Ben Thomas / Rick Knight PHONE: Business ______ Home ______

ADDRESS N Main St Mooresville NC 28115

LOCATION 115-21 S on (L) just past Hobbs Ln. Left Building

SUBDIVISION Torrence Towers BLOCK / SECTION ______ LOT 3 LOT AREA ~1.09 AC SITE CLASS PS DESIGN FLOW 480 L.T.A.R. .3

Septic Tank: 1500 Gallons; STB 1014 Date 10/21/95
Pump Tank: ______ Gallons; PT ______ Date ______
Pump Make: ______ Model ______ Serial No. 500
Nitrification Field: No Fields 1 Square Feet 1500 Linear Feet * ~~400~~
No Lines 4 5 Trench Width 36" Max Trench Bottom Depth 32" Gravel Depth N/A

☒ New System ☐ Repair System Type: I (II) III, IV, V, VI
System Description: ~~GRAVITY INFILTRATOR~~
Repair System Description: SAME
Maintenance Agreement Required: ☐ Yes ☒ No

☐ House/Mod. Home ☐ Mobile Home ☐ Business ☒ Other 2 - 2BD APTS
No. Bedrooms 4 No. Bathrooms ______ No. Employees ______


Water Supply: ☒ Individual ☐ Community ☐ Public

☐ Slab ☐ Crawl Space ☐ Basement w/plumbing ☐ Basement wo/plumbing

Comments: * 25% reduction for Infiltrator use

Comments: Gravity Conventional - Type II System

INITIAL SITE SKETCH AS BUILT SKETCH

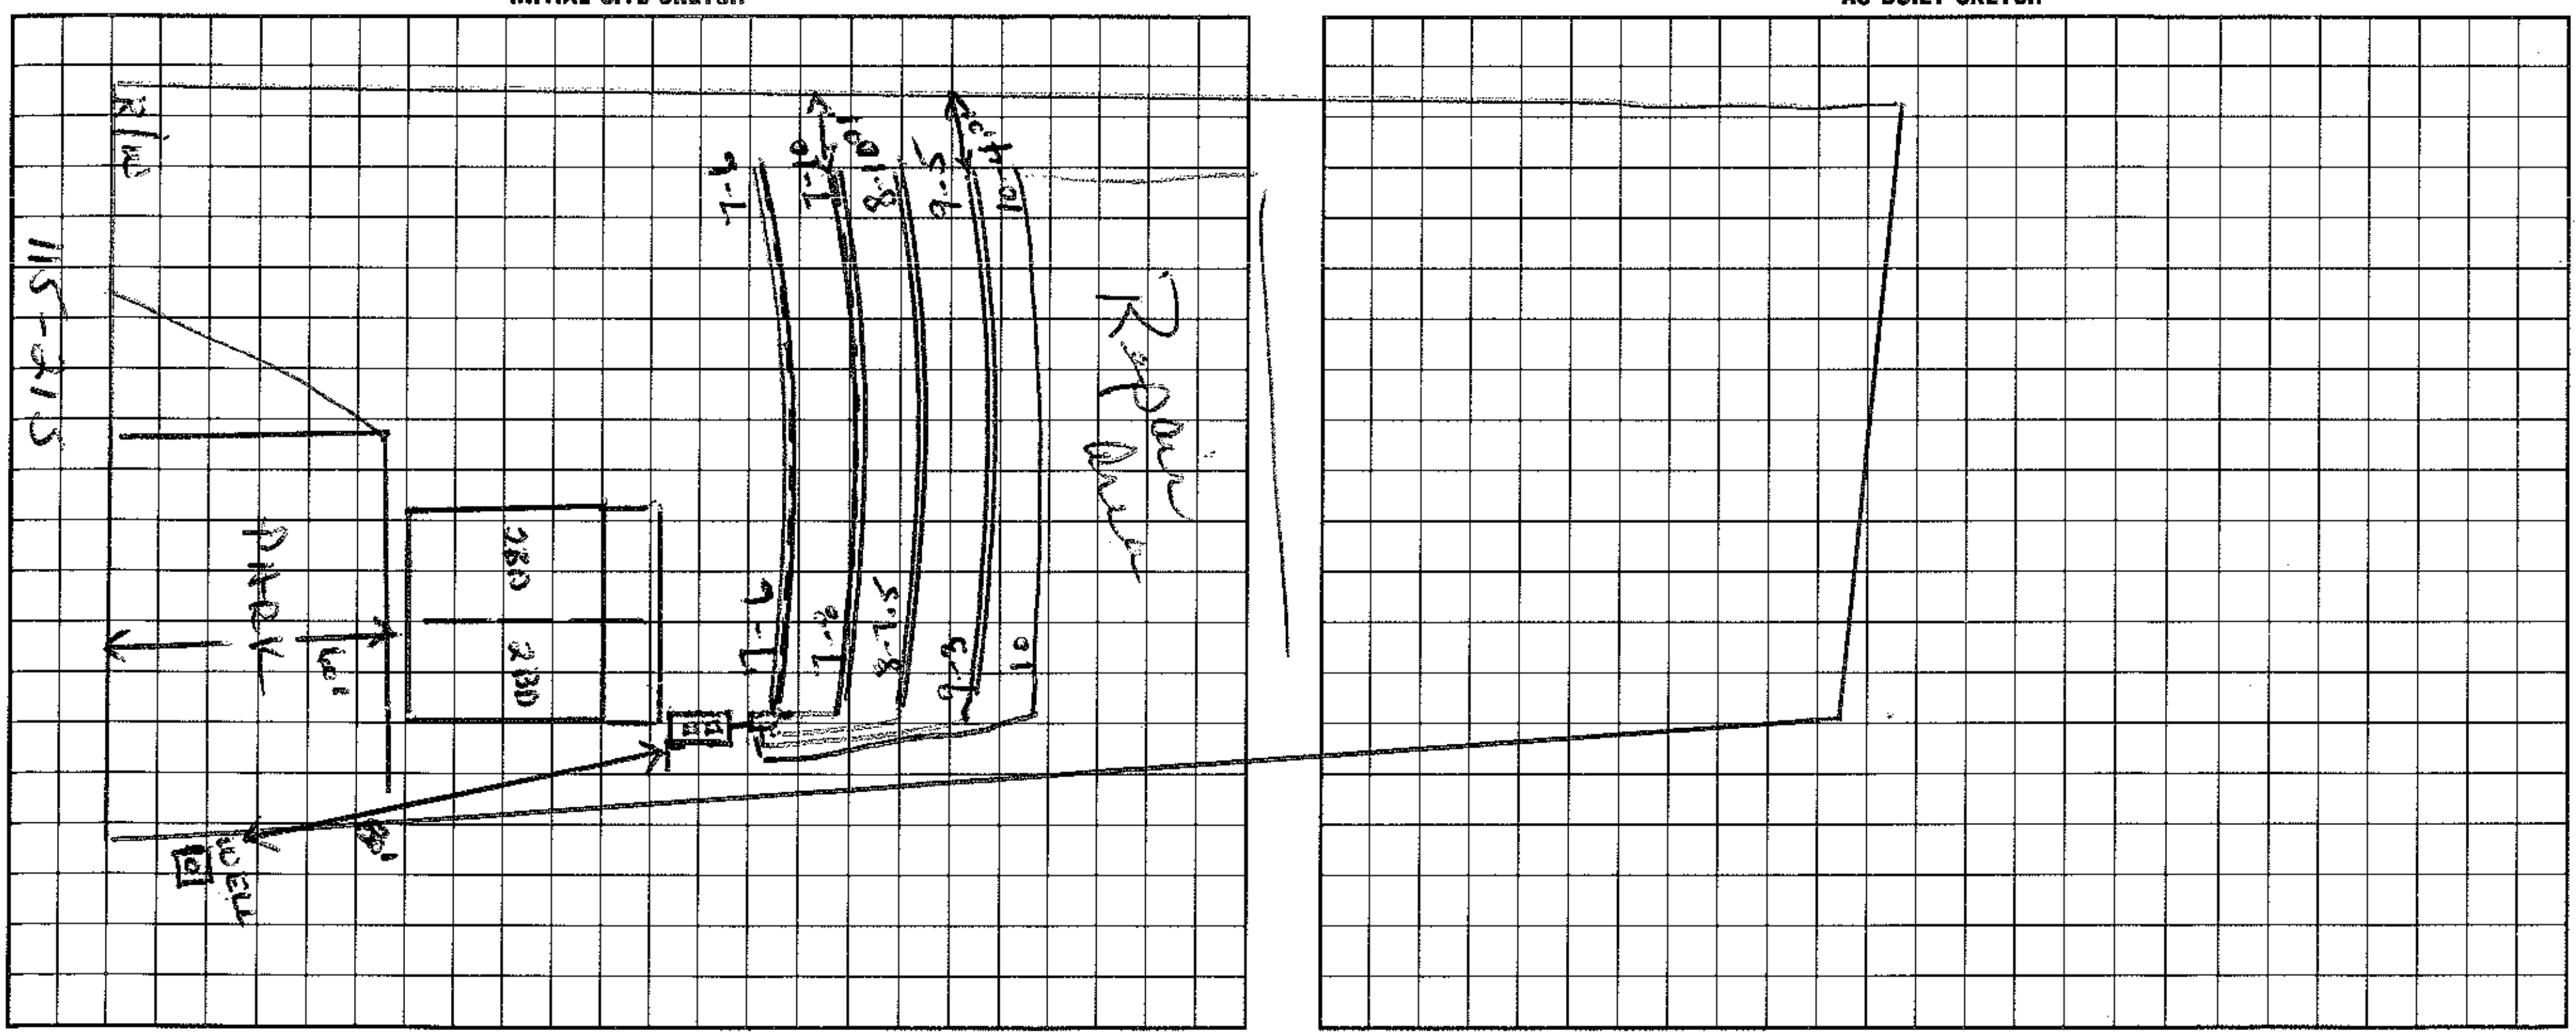

I understand that this permit can be suspended or revoked if any false information is supplied toward securing the permit/any unauthorized changes are made to the site/any unauthorized changes are made in the installation of the system.

Signed: Robert P. Rudisill, agent Installed by: Delbert Bostian

Improvement Permit by: Wesley Sparks RS. date 10/10/95 Certificate of Completion by: ______ date ______

Existing System Inspection by: authorization to Construct Wesley Sparks RS date 10/10/95 Operation Permit by: Wesley Sparks RS. date 3/12/96

HEALTH DEPT. COPY: WHITE INSPECTION COPY (FINAL): GREEN OWNER COPY (FINAL): YELLOW INSPECTION COPY (INITIAL): PINK OWNER COPY (INITIAL): GOLD