IREDELL COUNTY HEALTH DEPARTMENT

Authorization to Construct

4655 056328

STATESVILLE 704-878-5305 MOORESVILLE 704-664-5281

IMPROVEMENT PERMIT / ~~CERTIFICATE OF COMPLETION~~ / OPERATION PERMIT / EXISTING SYSTEM INSPECTION

PROPERTY DESCRIPTION NO. 22,118 DATE 10/16/95 TAX MAP NO. 2H 19 A 20 Watershed: ☐ Yes ☒ No

OWNER OR CONTRACTOR Ben Thomas PHONE: Business _____ Home _____

ADDRESS N Main St. Mooresville, NC 28115

LOCATION 115 S on (E) just past Hobbs lane - Right building

SUBDIVISION Torrence Tower BLOCK / SECTION _____ LOT 2 LOT AREA ~1.3 Ac SITE CLASS. DS DESIGN FLOW 480 L.T.A.R. .3

Septic Tank: 1500 Gallons; STB 1214 Date 10/14/95

Pump Tank: _____ Gallons; PT _____ Date _____

Pump Make: _____ Model _____ Serial No. _____

Nitrification Field: No Fields 1 Square Feet 1500 Linear Feet ~~X~~ 500

No Lines X5 Trench Width 36" Max Trench Bottom Depth 32" Gravel Depth N/A

☒ New System ☐ Repair System Type: I, II, (III) IV, V, VI

System Description: GRAV ~~INFILTRATOR~~

Repair System Description: SAME

Maintenance Agreement Required: ☐ Yes ☒ No

☐ House/Mod. Home No. Bedrooms ____

☐ Mobile Home No. Bathrooms ____

☐ Business No. Employees ____

☒ Other 2 - 2BDRM APTS


☐ Slab ☒ Crawl Space ☐ Basement w/plumbing ☐ Basement wo/plumbing

Water Supply:
☒ Individual
☐ Community
☐ Public


Comments: ~~X~~ Infiltration on Dist Box w Speed Leveler 25% reduction for Infiltration

Comments: Gravity Conventional - Type II System

INITIAL SITE SKETCH

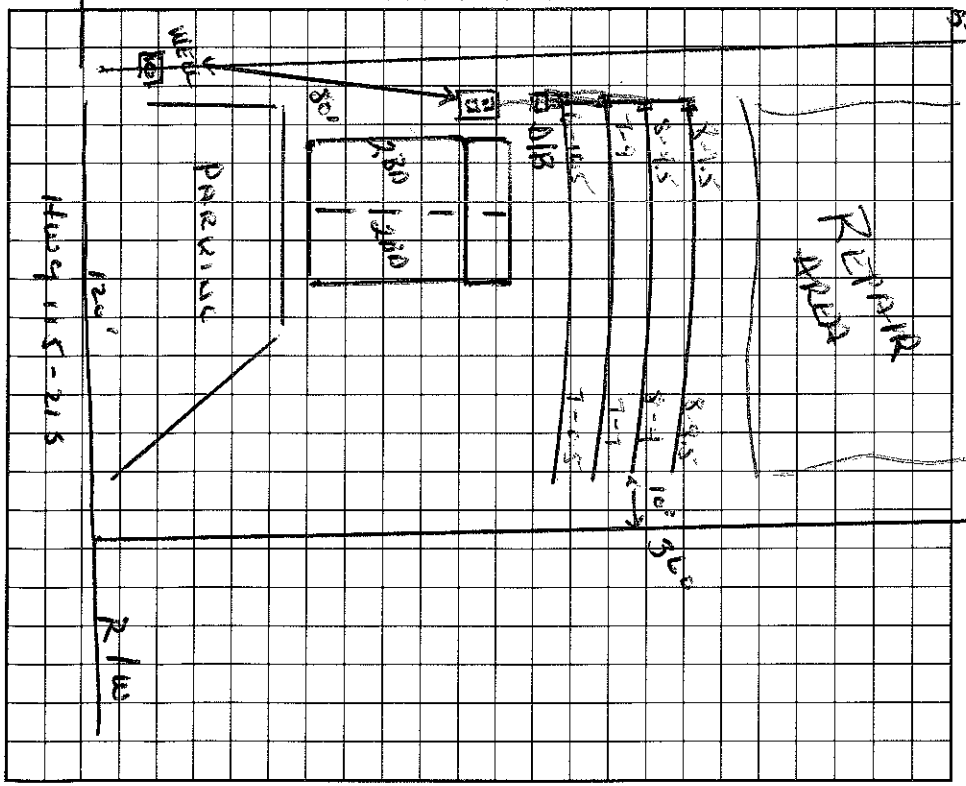

AS BUILT SKETCH

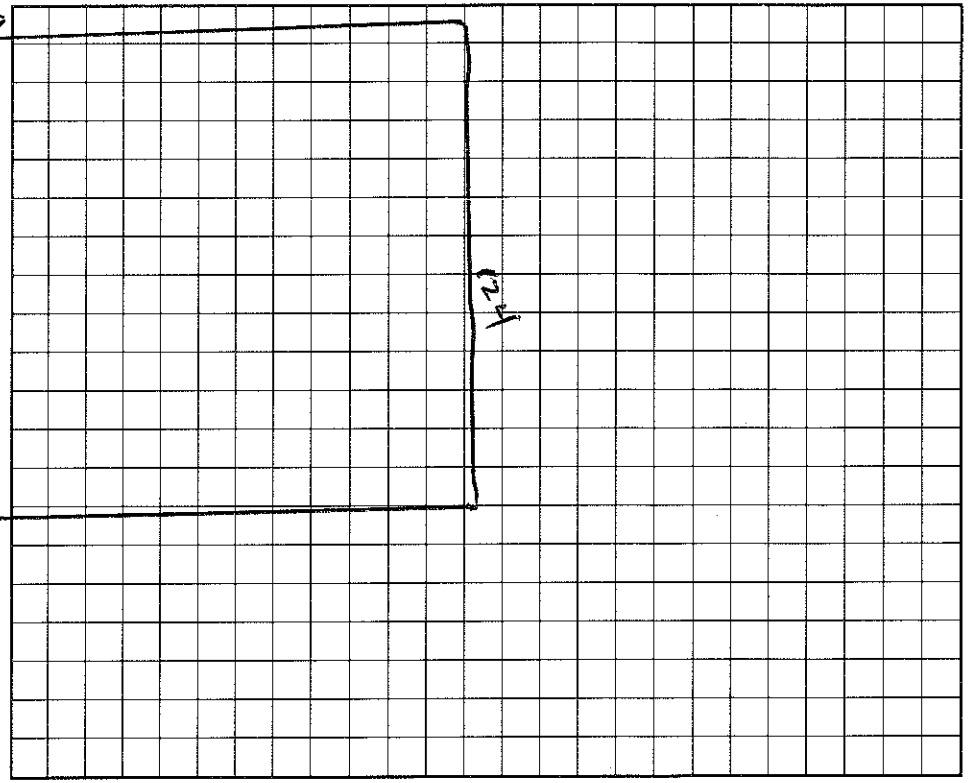

I understand that this permit can be suspended or revoked if any false information is supplied toward securing the permit/any unauthorized changes are made to the site/any unauthorized changes are made in the installation of the system.

Signed: Robert L. Cockrell, agent Installed by: Deflent Bastion

Improvement Permit by: Wesley Sparks RS. date 10/16/95 Certificate of Completion by: _____ date _____

Authorization to Construct Existing System Inspection by: Wesley Sparks date 10/16/95 Operation Permit by: Wesley Sparks RS. date 3/12/96

HEALTH DEPT. COPY: WHITE INSPECTION COPY (FINAL): GREEN OWNER COPY (FINAL): YELLOW INSPECTION COPY (INITIAL): PINK OWNER COPY (INITIAL): GOLD