IREDELL COUNTY HEALTH DEPARTMENT

Addition to Construct 4655 05 8886

STATESVILLE 704-878-5305 MOORESVILLE 704-664-5281

IMPROVEMENT PERMIT / ~~CERTIFICATE OF COMPLETION~~ / OPERATION PERMIT / EXISTING SYSTEM INSPECTION

PROPERTY DESCRIPTION NO. 22969 DATE 1/31/96 TAX MAP NO. 2H-19A-10 Watershed: ☐ Yes ☒ No

OWNER OR CONTRACTOR Virgil Mora PHONE: Business Home 663-3655 (LN Realty)

ADDRESS 19317 Davidson-Concord Rd. Davidson, NC. 28036

LOCATION Hobbs Lane - Mock Hwy 5 TL Hobbs Ln. ~ .1 mile - on (R) before 2nd house on (R)

SUBDIVISION Torrence Tavern BLOCK / SECTION A LOT 2 LOT AREA ~.95 Ac SITE CLASS LPS DESIGN FLOW 360 L.T.A.R. .35

Septic Tank: 1000 Gallons; STB 794 Date 5/2/96
Pump Tank: ____ Gallons; PT ____ Date ____
Pump Make: ____ Model ____ Serial No. ____
Nitrification Field: No Fields 1 Square Feet 1025 Linear Feet 345
No Lines 3 Trench Width 36" Max Trench Bottom Depth 36" Gravel Depth 12"

☒ New System ☐ Repair System Type: I, II, III, IV, V, VI
System Description: Diew Conventional
Repair System Description: Diew shift fraction
Maintenance Agreement Required: ☐ Yes ☒ No


☒ House/Mod. Home No. Bedrooms 3
☐ Mobile Home No. Bathrooms 2
☐ Business No. Employees ____
☐ Other ____
☐ Slab ☒ Crawl Space ☐ Basement w/plumbing ☐ Basement wo/plumbing

Water Supply:
☒ Individual
☐ Community
☐ Public


Comments: System shown here should not require pumping. House shift will make pumping necessary.

Comments:

INITIAL SITE SKETCH

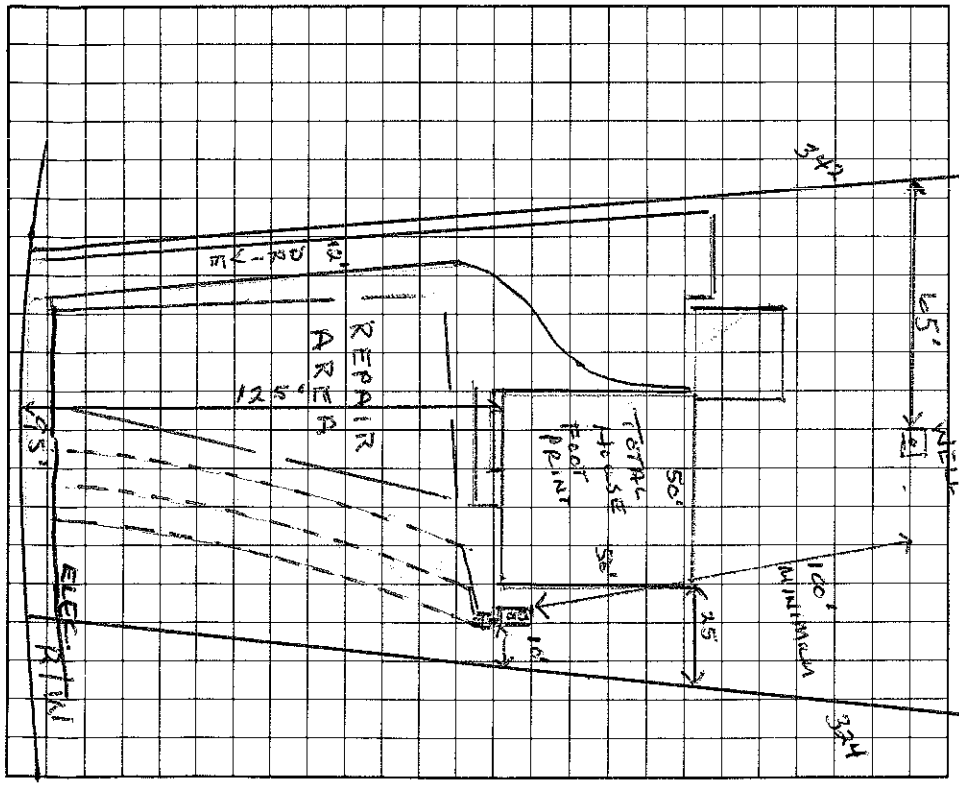

AS BUILT SKETCH

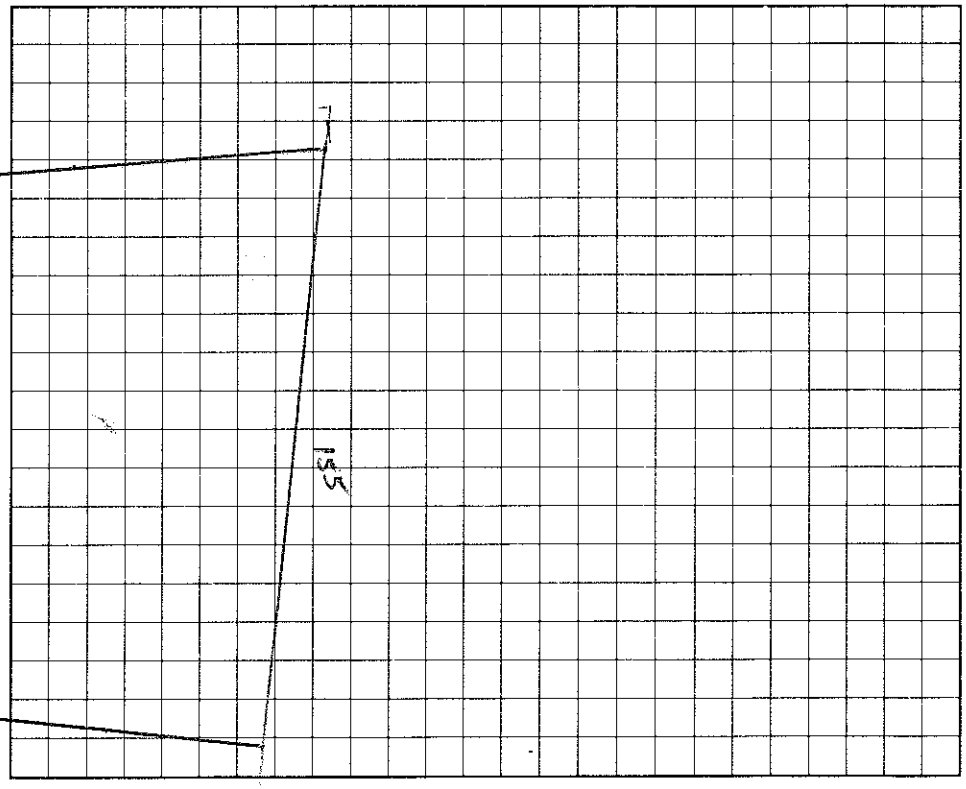

I understand that this permit can be suspended or revoked if any false information is supplied toward securing the permit/any unauthorized changes are made to the site/any unauthorized changes are made in the installation of the system.

Signed: X [signature]

Improvement Permit by: Wesley Sparks RS. date 1/31/96

Existing System Inspection by: Wesley Sparks RS. date 1/31/96

Installed by: Atlantic Excavating

Certificate of Completion by: ____ date ____

Operation Permit by: Wesley Sparks RS. date 6/6/96

HEALTH DEPT. COPY: WHITE INSPECTION COPY (FINAL): GREEN OWNER COPY (FINAL): YELLOW INSPECTION COPY (INITIAL): PINK OWNER COPY (INITIAL): GOLD