IREDELL COUNTY HEALTH DEPARTMENT

Statesville Phone TR 3-7271 Mooresville Phone NO 3-1271

PERMIT TO INSTALL SEPTIC TANK

Permit No. _____ Permit Date 27 Aug 19 65

Owner Bill Pope Address Mooresville N.

Installed By Sarge Address " "


Location of Property Mt Mourne Post Office

Tank		Capacity		Length of Lines		Fixtures	
Block	(✓)	1000	(✓)	225'	(✓)	No. of Baths	( )
Precast	( )	1250	( )	250'	( )	Dishwasher	( )
		1500	( )	Other _____		Garbage Grdr.	( )
		Other _____				Other _____	

NOTIFY HEALTH DEPARTMENT AT LEAST EIGHT HOURS BEFORE TANK IS TO BE INSPECTED.

Final Inspection 27 Aug 1965 Approved (✓) Disapproved ( )

Remarks Water Next Door.

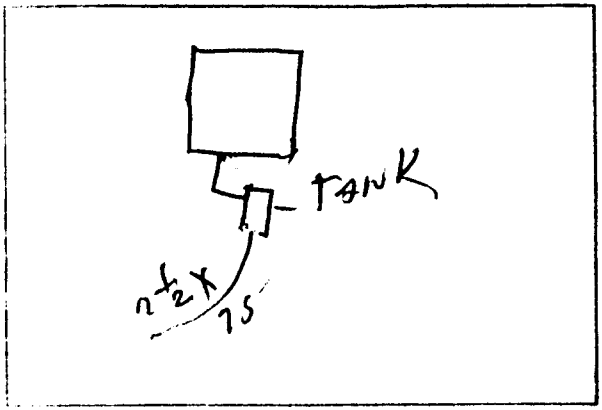

Sketch of Installation

Ivy Scoggins RS

Sanitarian