IREDELL COUNTY HEALTH DEPARTMENT

STATESVILLE 704-878-5305 MOORESVILLE 704-664-5281

IMPROVEMENT PERMIT / AUTHORIZATION TO CONSTRUCT / OPERATION PERMIT / EXISTING SYSTEM INSPECTION

PERMIT# REPAIR PIN# 1/20/98 4655 07 7950 DATE 1/26/98

OWNER OR CONTRACTOR PAUL MILLS PHONE: Business Home 663-1180

ADDRESS 153 HERITAGE PLACE MOORESVILLE, NC 28115

LOCATION 115-215 TL BEFORE FAITH RD, MH OFF DRIVEWAY 240

SUBDIVISION BLOCK / SECTION LOT 3 LOT AREA .536 SITE CLASS. DESIGN FLOW ~~360~~ L.T.A.R. 2

Septic Tank: 1000 Gallons; STB 825 Date 4/1/98

Pump Tank: ~~1000~~ Gallons; PT Date

Pump Make: Model Serial No. 2760

Nitrification Field: No. Fields 1 Square Feet 1200 Linear Feet

No Lines 5@84 Trench Width 36" Max Trench Bottom Depth ~30" Gravel Depth 12"

☐ New System ☒ Repair System Type: I, II, (III) IV, V, VI

System Description: Pressure - Conventional

Repair System Description: Same

Maintenance Agreement Required: ☐ Yes ☒ No

☐ House/Mod. Home ☒ Mobile Home ☐ Business ☐ Other

No. Bedrooms 3 No. Bathrooms 2 No. Employees

☐ Slab ☒ Crawl Space ☐ Basement w/plumbing ☐ Basement wo/plumbing

Water Supply: ☒ Individual ☐ Public ☐ Community

Comments/Conditions: Necessary to pump through low area to get to field on other side of woods.

40@67'x3'

Comments/Conditions:

3 @ 240


3 @ 90"

270


24

30

INITIAL SITE SKETCH

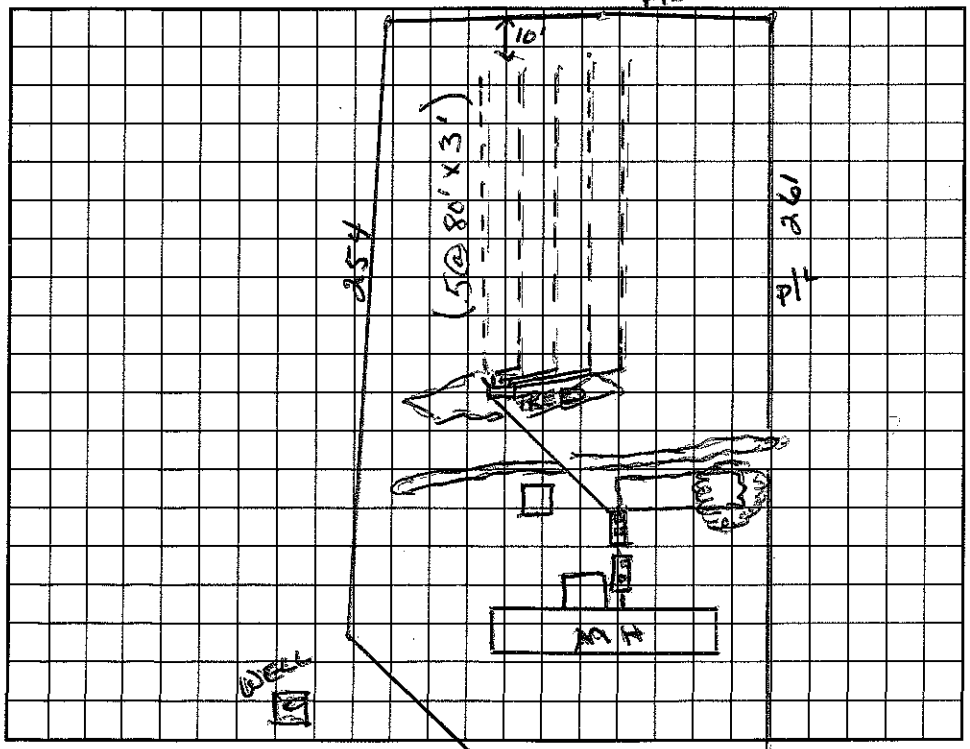

AS BUILT SKETCH

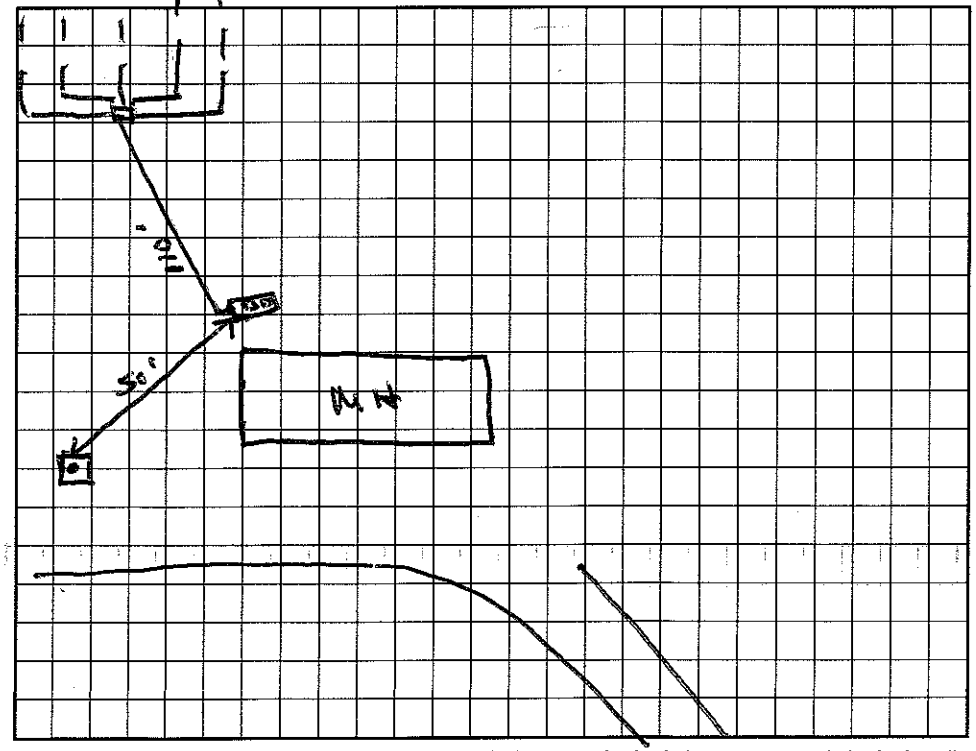

I understand that this permit can be suspended or revoked if any false information is supplied toward securing the permit/any unauthorized changes are made to the site/any unauthorized changes are made in the installation of the system. Improvement Permit with plat valid without expiration. Improvement Permit with site plan valid for sixty months. Authorization to Construct is valid for a period equal to that of Improvement Permit – not to exceed sixty months.

Signed: X Paul Mills date

Improvement Permit by: Wesley Sparks R.S. date 1/20/98

Authorization to Construct by: Wesley Sparks R.S. date 1/20/98

Installed by: K & K Grading

Operation Permit by: Wesley Sparks R.S. date 7/7/98

Existing System Inspection by: date

HEALTH DEPT. COPY: WHITE INSPECTION COPY (FINAL): GREEN OWNER COPY (FINAL): YELLOW INSPECTION COPY (INITIAL): PINK OWNER COPY (INITIAL): GOLD