4055-09-7909 Authorization to Construct 400

IREDELL COUNTY HEALTH DEPARTMENT

STATESVILLE 704-878-5305 MOORESVILLE 704-664-5281

IMPROVEMENT PERMIT / ~~CERTIFICATE OF COMPLETION~~ / OPERATION PERMIT / EXISTING SYSTEM INSPECTION

PROPERTY DESCRIPTION NO. 25517 DATE 12/27/96 TAX MAP NO. 2H 4 B 22 Watershed: ☐ Yes ☒ No

OWNER OR CONTRACTOR Pamela S. Tennant PHONE: Business _____ Home 892-5265

ADDRESS PO Box 116 Mt Mourne, NC. 28123

LOCATION 158 Leslie Loop. 115 S TR Leslie Loop TR 158 on (E) Leslie Loop driveway

SUBDIVISION Royal Oaks BLOCK / SECTION _____ LOT 82 LOT AREA 100 x 186 SITE CLASS PS DESIGN FLOW 360 L.T.A.R. .3

Septic Tank: 1000 Gallons; STB 794 Date 9-15-95

Pump Tank: _____ Gallons; PT _____ Date _____

Pump Make: _____ Model _____ Serial No. _____

Nitrification Field: No Fields 1 Square Feet 1200 Linear Feet 400

No Lines 4 + 4 Trench Width 36" Max Trench Bottom Depth 30" Gravel Depth 12"

☒ New System ☐ Repair System Type: I II III IV, V, VI

System Description: GRAV - CONVENTIONAL

Repair System Description: SAME

Maintenance Agreement Required: ☐ Yes ☒ No

☐ House/Mod. Home No. Bedrooms 3

☒ Mobile Home No. Bathrooms 2

☐ Business No. Employees _____

☐ Other _____

☐ Slab ☒ Crawl Space ☐ Basement w/plumbing ☐ Basement wo/plumbing

Water Supply:
☒ Individual
☐ Community
☐ Public
EXISTING


Comments:

RAILROAD

Comments:

Installed as drawn.

INITIAL SITE SKETCH

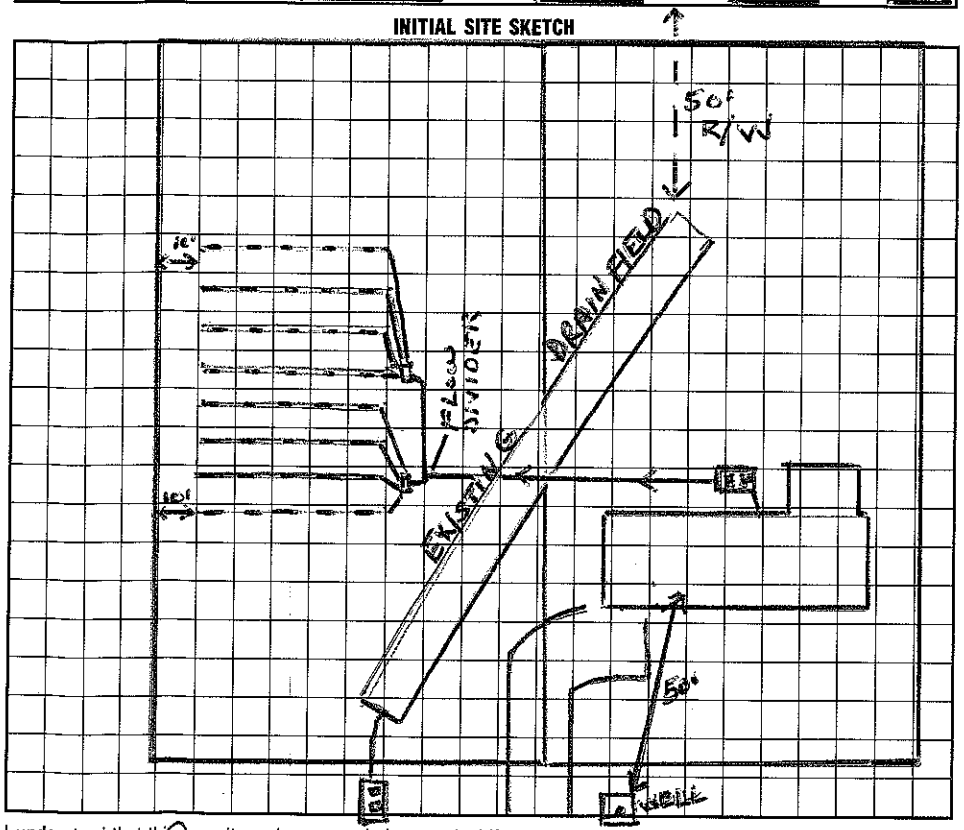

AS BUILT SKETCH

I understand that this permit can be suspended or revoked if any false information is supplied toward securing the permit/any unauthorized changes are made to the site/any unauthorized changes are made in the installation of the system.

Signed: ✱ Pamela S. Tennant 12/30/96

Improvement Permit by: Wesley Sparks R.S. date 12/27/96

Authorization to Construct Wesley Sparks R.S. date 12/27/96

Existing System Inspection by: _____ date _____

Installed by: Tims Septic Tank Service

Certificate of Completion by: (illegible) Wesley Sparks R.S. date 11/12/97

Operation Permit by: Wesley Sparks R.S. date 11/12/97

HEALTH DEPT. COPY: WHITE INSPECTION COPY (FINAL): GREEN OWNER COPY (FINAL): YELLOW INSPECTION COPY (INITIAL): PINK OWNER COPY (INITIAL): GOLD