IREDELL COUNTY HEALTH DEPARTMENT - *ENVIRONMENTAL HEALTH* ☐ STATESVILLE OFFICE 704-878-5305 ☒ MOORESVILLE OFFICE 704-664-5281

IMPROVEMENT PERMIT / AUTHORIZATION TO CONSTRUCT / OPERATION PERMIT / EXISTING SYSTEM INSPECTION

PERMIT # — PIN # ~~4655-13-0590~~ 9655131584 DATE 6-16-11

OWNER JERRY ARCHER APPLICANT: SAME PHONE: Home/Cell # 704-400-0487 Business #

SITE ADDRESS 1703 MECKLENBURG HWY OWNER / APPLICANT ADDRESS 304 PRESBYTERIAN RD

SITE DIRECTIONS 1155

SUBDIVISION BLOCK / SECTION LOT # LOT AREA ~1 AC DESIGN FLOW 360 L.T.A.R. .35 / .3R

Septic Tank 1000 Gallons: STB 825 Date 4-11-11 — ☒ New System ☐ Repair ☐ Expansion System Type I II III IV V VI — ☒ Residence No. Bedrooms 3 — Water Supply: ☒ Private

Pump Tank Gallons: PT Date — System Description: 25% REDUCTION — ☐ Business No. Persons — ☐ Public


Pump Make Model Serial # — Repair System Description: SAME — ☐ Other No. Employees — ☐ Community

No. Nitrification Fields: 1 No. Lines 3 Linear Feet 260' — Maintenance Agreement Required ☐ YES ☒ NO — ☐ Slab ☒ Crawl Space


Trench Width 36" Max. Trench Bottom Depth 24" Gravel Depth — ☒ GRAVITY ☐ PRESSURE — ☐ Basement w/plumbing ☐ Basement w/o plumbing

Comments / Conditions ① SLEEVE PIPE UNDER DRIVEWAY ② STAY OUT OF OLD SYSTEM ③ PUMP, CRUSH & FILL OLD TANK

INITIAL SITE SKETCH

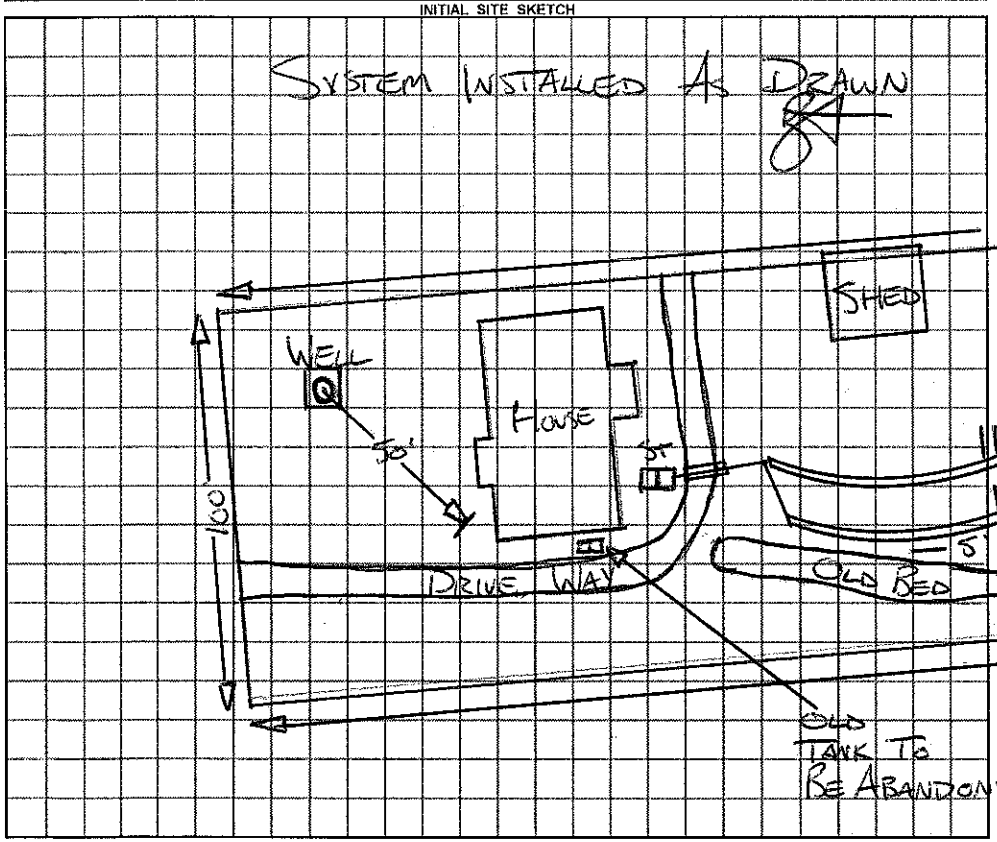

AS BUILT SKETCH

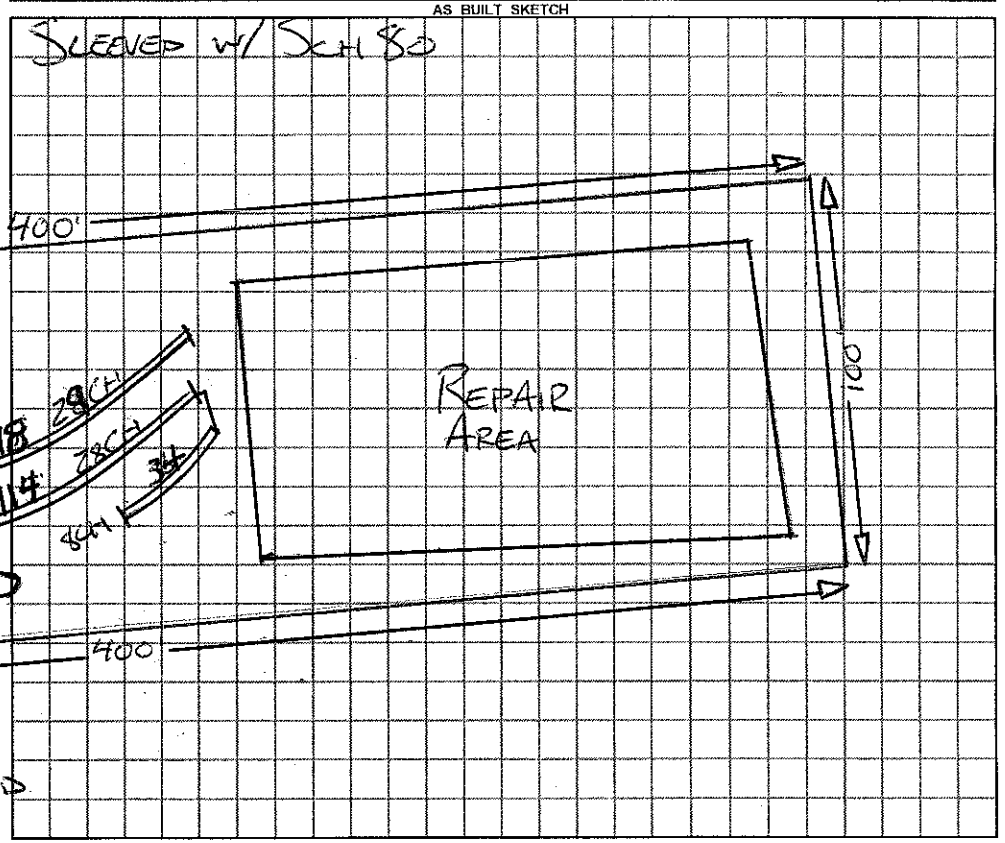

Permit can be suspended or revoked if any false information is supplied toward securing the permit / any unauthorized changes are made to the site / any unauthorized changes are made in the installation of the system.

☐ ***IMPROVEMENT PERMIT*** *with plat valid without expiration.* ☒ ***IMPROVEMENT PERMIT*** *with plat valid without expiration. site plan valid 60 mo.* ☒ ***AUTHORIZATION TO CONSTRUCT*** valid for period equal to IMPROVEMENT PERMIT--not to exceed 60 mo.

Owner / Applicant Signature: Jerry Archer Date Installed by: ROWAN SEPTIC

IMPROVEMENT PERMIT by: REHS Date 6-20-11 OPERATION PERMIT by: REHS Date 6-24-11

AUTHORIZATION TO CONSTRUCT by: REHS Date 6-20-11 Existing System Inspected by: REHS Date

YOU SHOULD CONTACT A LOCATOR SERVICE PRIOR TO ANY EXCAVATION

White Copy – Environmental Health YELLOW COPY (Final) Owner / Applicant PINK COPY (Initial) Owner / Applicant