4655137144

IREDELL COUNTY HEALTH DEPARTMENT

STATESVILLE 704-878-5305 MOORESVILLE 704-664-5281

IMPROVEMENT PERMIT / CERTIFICATE OF COMPLETION / OPERATION PERMIT / EXISTING SYSTEM INSPECTION

PROPERTY DESCRIPTION NO. _____ DATE Dec 1, '95 TAX MAP NO. _____ Watershed: ☐ Yes ☐ No

OWNER OR CONTRACTOR Roxanne Phillips PHONE: Business 875-4441 Home _____

ADDRESS 174 Eastpoint Lane

LOCATION 115 S Th EASTpoint Th TR EASTpoint LANE 2nd house on Right

SUBDIVISION _____ BLOCK / SECTION _____ LOT _____ LOT AREA _____ SITE CLASS. _____ DESIGN FLOW _____ L.T.A.R. _____

Septic Tank: Existing Gallons; STB _____ Date _____

Pump Tank: _____ Gallons; PT _____ Date _____

Pump Make: _____ Model _____ Serial No. _____

Nitrification Field: No Fields ___ Square Feet _____ Linear Feet 240'+

No Lines 3 in bed Trench Width 9'x80' Max Trench Bottom Depth _____ Gravel Depth 12"+

☐ New System ☑ Repair System Type: I, II, III, IV, V, VI

System Description: 4 Gravel Bed

Repair System Description: BRVALVE to 9' Bed

Maintenance Agreement Required: ☐ Yes ☑ No

☑ House/Mod. Home No. Bedrooms 3

☐ Mobile Home No. Bathrooms 2

☐ Business No. Employees ___

☐ Other _____

☐ Slab ☑ Crawl Space ☐ Basement w/plumbing ☐ Basement wo/plumbing


Water Supply: ☑ Individual ☐ Community ☐ Public

Comments:

Install new trench no deeper than necessary to get fall from septic tank OR to install more footage than shown if space allows

Comments:

INITIAL SITE SKETCH

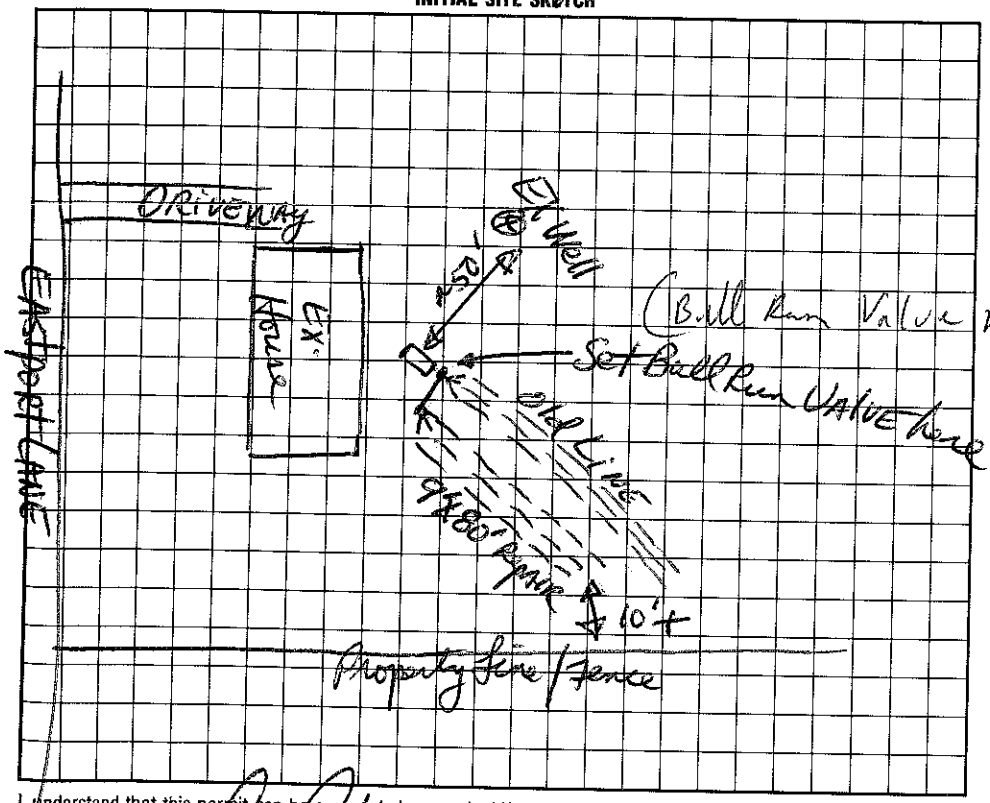

(Bell Run Valve not installed)

AS BUILT SKETCH

I understand that this permit can be suspended or revoked if any false information is supplied toward securing the permit/any unauthorized changes are made to the site/any unauthorized changes are made in the installation of the system.

Signed: _____

Improvement Permit by: _____ date 12-1-95

Existing System Inspection by: _____ date _____

Installed by: Jamie's Grading

Certificate of Completion by: _____ date _____

Operation Permit by: _____ date 6/17/96

HEALTH DEPT. COPY: WHITE INSPECTION COPY (FINAL): GREEN OWNER COPY (FINAL): YELLOW INSPECTION COPY (INITIAL): PINK OWNER COPY (INITIAL): GOLD