4655-14-3351

IREDELL COUNTY HEALTH DEPARTMENT

STATESVILLE 704-878-5305 MOORESVILLE 704-664-5281

IMPROVEMENT PERMIT / CERTIFICATE OF COMPLETION / OPERATION PERMIT / EXISTING SYSTEM INSPECTION

PROPERTY DESCRIPTION NO. 24576 DATE 9/5/96 TAX MAP NO. 2H B 56 Watershed: ☐ Yes ☒ No

OWNER OR CONTRACTOR MaryAnn McCall - JJ Mobile Home PHONE: Business 892-4702 Home

ADDRESS Eastpoint Ln. Mooresville NC. 28115

LOCATION Eastpoint Ln. TL thenquick (R) aboutacurve to 5th lot on (L)

SUBDIVISION J+JMHP BLOCK / SECTION LOT 6B LOT AREA Existy SITE CLASS. PS DESIGN FLOW 360 L.T.A.R.

Septic Tank: Existy Gallons; STB Date

Pump Tank: Gallons; PT Date

Pump Make: Model Serial No.

Nitrification Field: No Fields Square Feet Existy Linear Feet

No Lines Trench Width Existy Max ~~Trench Bottom~~ Depth Gravel Depth

☐ New System ☐ Repair System Type: I, (II), III, IV, V, VI

System Description: Existy System

Repair System Description:

Maintenance Agreement Required: ☐ Yes ☐ No

☐ House/Mod. Home ☒ Mobile Home ☐ Business ☐ Other

No. Bedrooms 3 No. Bathrooms 2 No. Employees

☐ Slab ☐ Crawl Space ☐ Basement w/plumbing ☐ Basement wo/plumbing


Water Supply: ☐ Individual ☒ Community ☐ Public

Comments:

Comments:

INITIAL SITE SKETCH

AS BUILT SKETCH

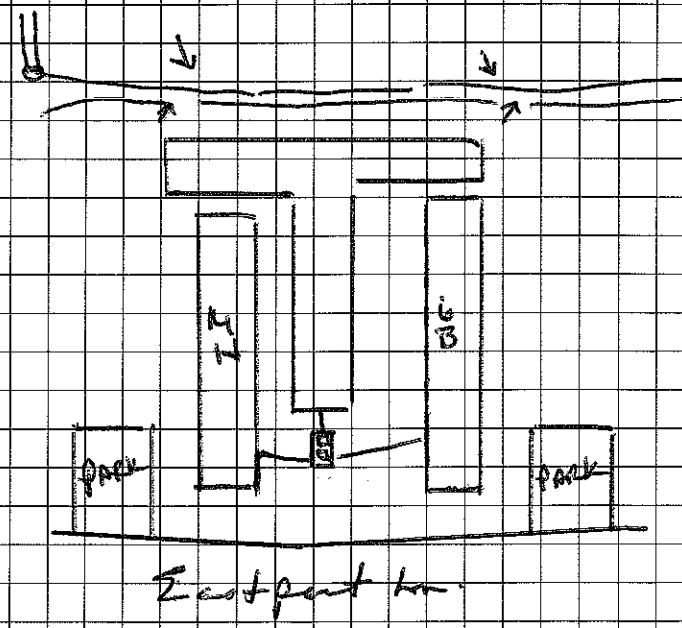

I understand that this permit can be suspended or revoked if any false information is supplied toward securing the permit/any unauthorized changes are made to the site/any unauthorized changes are made in the installation of the system.

Signed:

Improvement Permit by: date

Existing System Inspection by: date

Installed by:

Certificate of Completion by: Existing System Working Properly date 9/5/96

Operation Permit by: date

HEALTH DEPT. COPY: WHITE INSPECTION COPY (FINAL): GREEN OWNER COPY (FINAL): YELLOW INSPECTION COPY (INITIAL): PINK OWNER COPY (INITIAL): GOLD