4655-14-4238

IREDELL COUNTY HEALTH DEPARTMENT

STATESVILLE 704-878-5305 MOORESVILLE 704-664-5281

IMPROVEMENT PERMIT / CERTIFICATE OF COMPLETION / OPERATION PERMIT / EXISTING SYSTEM INSPECTION

PROPERTY DESCRIPTION NO. 24053 DATE 5/31/96 TAX MAP NO. 2H B 56 Watershed: ☐ Yes ☒ No

OWNER OR CONTRACTOR J+J MH Park Mary Ann McCall PHONE: Business 892-4702 Home

ADDRESS 21017 Lakeview Cir Davidson, NC. 28036

LOCATION 115 S to East Pt, straight into park Second Ln. to 5th spot on (L)

SUBDIVISION J+J MH Park BLOCK / SECTION LOT 5B LOT AREA SITE CLASS. DESIGN FLOW L.T.A.R.

Septic Tank: Trinity Gallons; STB Date

Pump Tank: Gallons; PT Date

Pump Make: Model Serial No.

Nitrification Field: No Fields Square Feet Linear Feet

No Lines Trench Width Max Trench Bottom Depth Gravel Depth

☐ New System ☐ Repair System Type: I. (II) III. IV. V. VI

System Description: Trinity System

Repair System Description:

Maintenance Agreement Required: ☐ Yes ☐ No

☐ House/Mod. Home No. Bedrooms 3

☒ Mobile Home No. Bathrooms 1

☐ Business No. Employees

☐ Other

☐ Slab ☒ Crawl Space ☐ Basement w/plumbing ☐ Basement wo/plumbing


Water Supply:
☐ Individual
☒ Community
☐ Public

Comments:

Comments:

INITIAL SITE SKETCH

NOT TO SCALE AS BUILT SKETCH

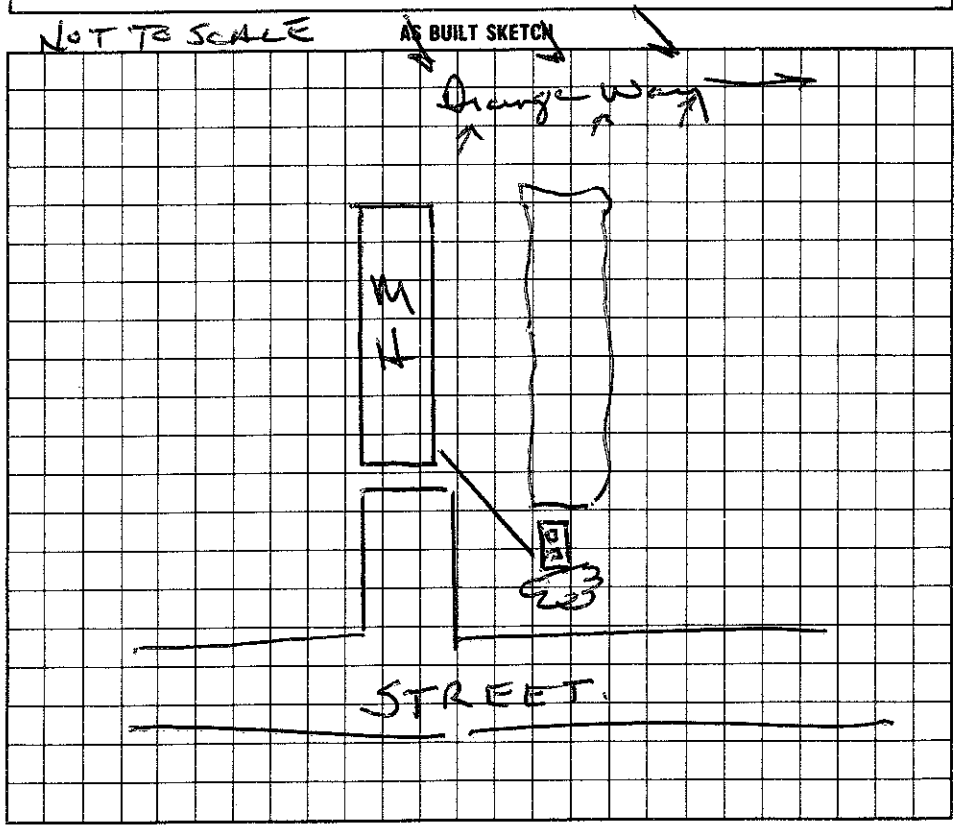

I understand that this permit can be suspended or revoked if any false information is supplied toward securing the permit/any unauthorized changes are made to the site/any unauthorized changes are made in the installation of the system.

Signed:

Improvement Permit by: date

Existing System Inspection by: date

Installed by: Trinity System Workers. date 5/31/96

Certificate of Completion by: date

Operation Permit by: date

HEALTH DEPT. COPY: WHITE INSPECTION COPY (FINAL): GREEN OWNER COPY (FINAL): YELLOW INSPECTION COPY (INITIAL): PINK OWNER COPY (INITIAL): GOLD