IREDELL COUNTY HEALTH DEPARTMENT

4655-14-3271

STATESVILLE 704-878-5305 MOORESVILLE 704-664-5281

IMPROVEMENT PERMIT / CERTIFICATE OF COMPLETION / OPERATION PERMIT / EXISTING SYSTEM INSPECTION

PROPERTY DESCRIPTION NO. BLANKET PD. DATE 7/30/93

OWNER OR CONTRACTOR J+J MOBILE HOME PARK TAX MAP NO. H14

ADDRESS EASTPORT LN MOORESVILLE, NC. PHONE: Business Home

LOCATION EASTPORT LN, 115 S TL ON EASTPORT LN L AT STOP INTO PARK STRAIGHT TO FIRST SPACE ON (L) PAST WELLHOUSE

SUBDIVISION J+J MH PARK BLOCK / SECTION LOT 4B LOT AREA SITE CLASS. L.T.A.R.

Water Supply: ☐ Individual ☑ Community ☐ Public D/W

Septic Tank: EXISTING Gallons; STB Date

Pump Tank: Gallons; PT Date

Nitrification Field: No Fields Square Feet Linear Feet

No Lines Trench Width Trench Depth Gravel Depth

☐ New System ☐ Repair System Type: I (II) II, IV, V, VI

System Description:

Repair System Description:

Maintenance Agreement Required: ☐ Yes ☑ No

☑ House/Mod. Home ☐ Mobile Home ☐ Business ☐ Other

No. Bedrooms 3 No. Bathrooms 2 No. Employees

Garbage Disposal: ☐ Yes ☑ No

Auto. Dishwasher: ☑ Yes ☐ No

Auto. Washing Machine: ☑ Yes ☐ No


Other

☐ Slab ☑ Crawl Space ☐ Basement w/plumbing ☐ Basement wo/plumbing

Comments

INITIAL SITE SKETCH

AS BUILT SKETCH

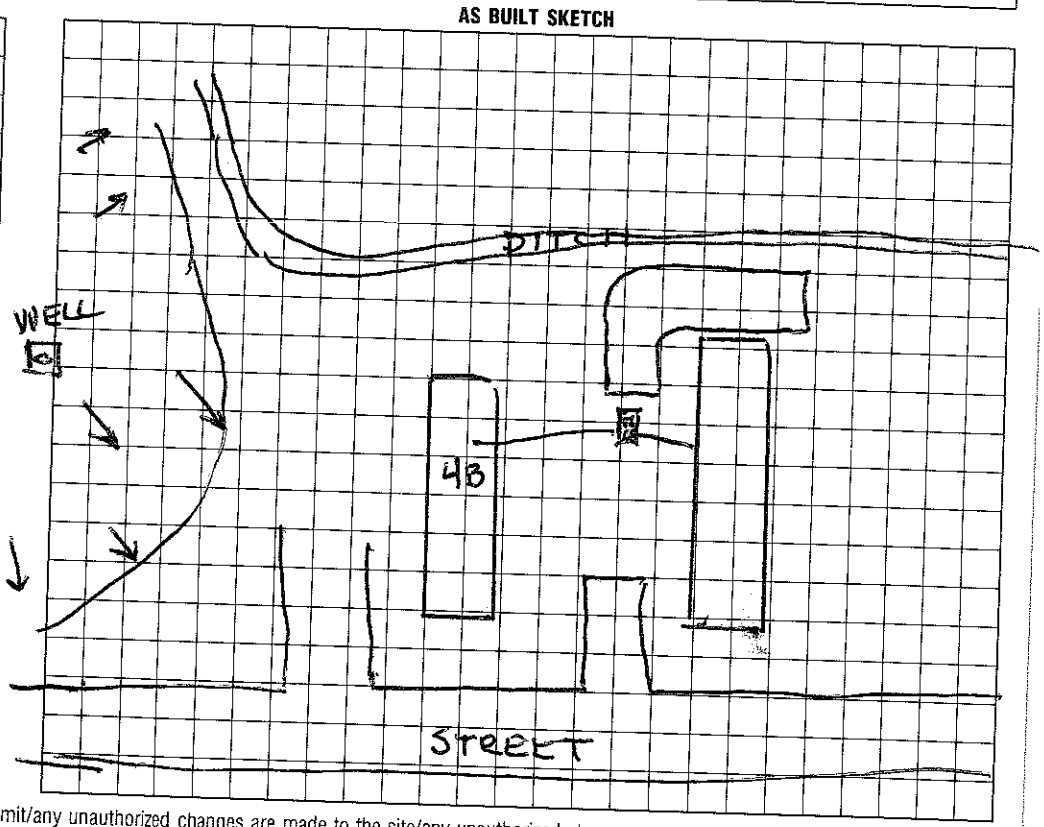

I understand that this permit can be suspended or revoked if any false information is supplied toward securing the permit/any unauthorized changes are made to the site/any unauthorized changes are made in the installation of the system. Improvement Permit is valid for 60 months from date of issuance.

Signed:

Improvement Permit by: date

Existing System Inspection by: Wesley Sparks R.S. date 7/30/93

Installed by:

Certificate of Completion by: date

Operation Permit by: date

HEALTH DEPT. COPY: WHITE INSPECTION COPY (FINAL): GREEN OWNER COPY (FINAL): YELLOW INSPECTION COPY (INITIAL): PINK OWNER COPY (INITIAL): GOLD