4655-14-4621

# IREDELL COUNTY HEALTH DEPARTMENT

STATESVILLE 704-878-5305 MOORESVILLE 704-664-5281

## IMPROVEMENT PERMIT / CERTIFICATE OF COMPLETION / OPERATION PERMIT / EXISTING SYSTEM INSPECTION

PROPERTY DESCRIPTION NO. REPAIR DATE 9/3/93 TAX MAP NO. N/A

OWNER OR CONTRACTOR J+J MOBILE HOME PARK (MILDRED JOHNSON) PHONE: Business 892-6943 Home

ADDRESS EASTPORT RD.

LOCATION TO REAR OF PARK, TL TO 2ND TRAILER ON (R)

SUBDIVISION BLOCK / SECTION LOT 16 LOT AREA EXISTING6 SITE CLASS. L.T.A.R.

Water Supply: ☐ Individual ☑ Community ☐ Public

Septic Tank: 1000 Gallons; STB 358 Date 7/12/93

Pump Tank: Gallons; PT Date

Nitrification Field: No Fields 3 Square Feet 450 Linear Feet 135

No Lines 3 Trench Width 10" Trench Depth 36" Gravel Depth 12"

☑ New System ☐ Repair System Type: I, (II), II, IV, V, VI

System Description: BED

Repair System Description: BED

Maintenance Agreement Required: ☐ Yes ☐ No

☑ House/Mod. Home No. Bedrooms 3 Garbage Disposal: ☐ Yes ☑ No

☐ Mobile Home No. Bathrooms 2 Auto. Dishwasher: ☑ Yes ☐ No

☐ Business No. Employees Auto. Washing Machine: ☑ Yes ☐ No


☐ Other Other

☐ Slab ☑ Crawl Space ☐ Basement w/plumbing ☐ Basement wo/plumbing

Comments

**INITIAL SITE SKETCH**

**AS BUILT SKETCH**

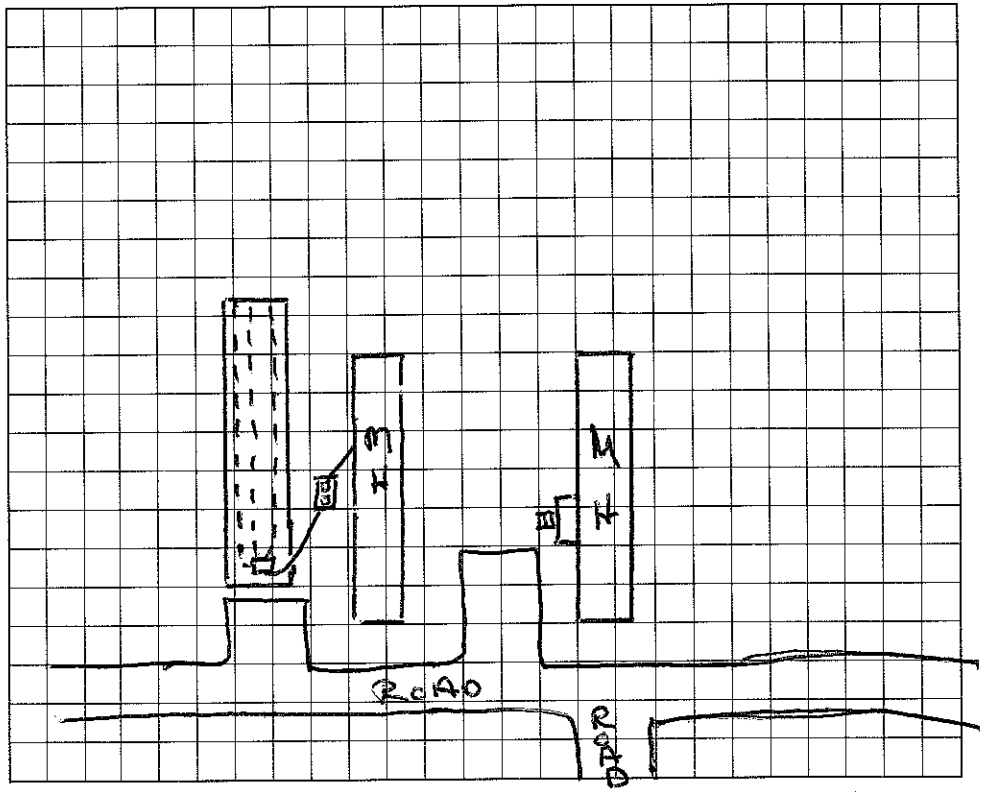


I understand that this permit can be suspended or revoked if any false information is supplied toward securing the permit/any unauthorized changes are made to the site/any unauthorized changes are made in the installation of the system. Improvement Permit is valid for 60 months from date of issuance.

Signed:

Improvement Permit by: date

Existing System Inspection by: date

Installed by: Larry Beam

Certificate of Completion by: Wesley Sparks RS, date 9/3/93

Operation Permit by: date

HEALTH DEPT. COPY: WHITE INSPECTION COPY (FINAL): GREEN OWNER COPY (FINAL): YELLOW INSPECTION COPY (INITIAL): PINK OWNER COPY (INITIAL): GOLD