COPY

# IREDELL COUNTY HEALTH DEPARTMENT

STATESVILLE 704-878-5305 MOORESVILLE 704-664-5281

## IMPROVEMENT PERMIT / AUTHORIZATION TO CONSTRUCT / OPERATION PERMIT / EXISTING SYSTEM INSPECTION

PERMIT# 073060 PIN# ~~4655150415~~ (PHILLIP & LINDA VANARSDALE) 4655 15 0415 DATE 8/20/98

OWNER OR CONTRACTOR ~~PETER LUKAS~~ PHONE: Business _____ Home 489-2557

ADDRESS 5005 CHUCKS LN. DENVER NC 28037

LOCATION 115 - TL HOBBS AT END ON RT.

SUBDIVISION TORRENCE TAVERN est. BLOCK / SECTION BIKA LOT ~~13~~ 5 LOT AREA 2.19AC SITE CLASS. PS DESIGN FLOW 360 GPD L.T.A.R. .36 PD/FT²

Septic Tank: 1000 Gallons; STB 312 Date 9/6/99

Pump Tank: 1000 Gallons; PT 283 Date 1/29/00

Pump Make: GOULDS Model WE0-511H Serial No. 2/1/00

Nitrification Field: No Fields 1 Square Feet 400 Linear Feet 200

No Lines ~~4 @ 50'~~ Trench Width 24" Max Trench Bottom Depth 36" Gravel Depth _____

☑ New System ☐ Repair System Type: I, II, (III), IV, V, VI

System Description: PUMP PANEL

Repair System Description: SAME

Maintenance Agreement Required: ☐ Yes ☑ No

☑ House/Mod. Home No. Bedrooms 3

☐ Mobile Home No. Bathrooms 2

☐ Business No. Employees _____

☐ Other _____

☐ Slab ☐ Crawl Space ☑ Basement w/plumbing ☐ Basement wo/plumbing


Water Supply: ☑ Individual ☐ Public ☐ Community

Comments:/Conditions:


SITE PLAN APPROVED TO MOVE HOUSE FURTHER FROM STREET. CBF - 10/1/99

Comments:/Conditions: 3@67'x3' installed

**INITIAL SITE SKETCH**

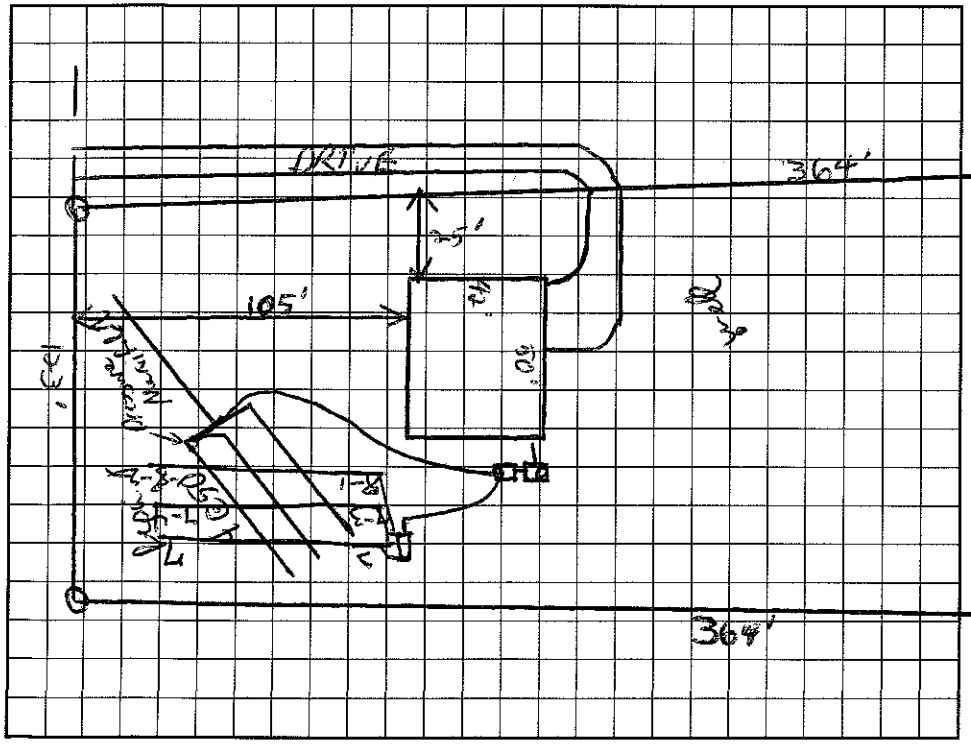


**AS BUILT SKETCH**

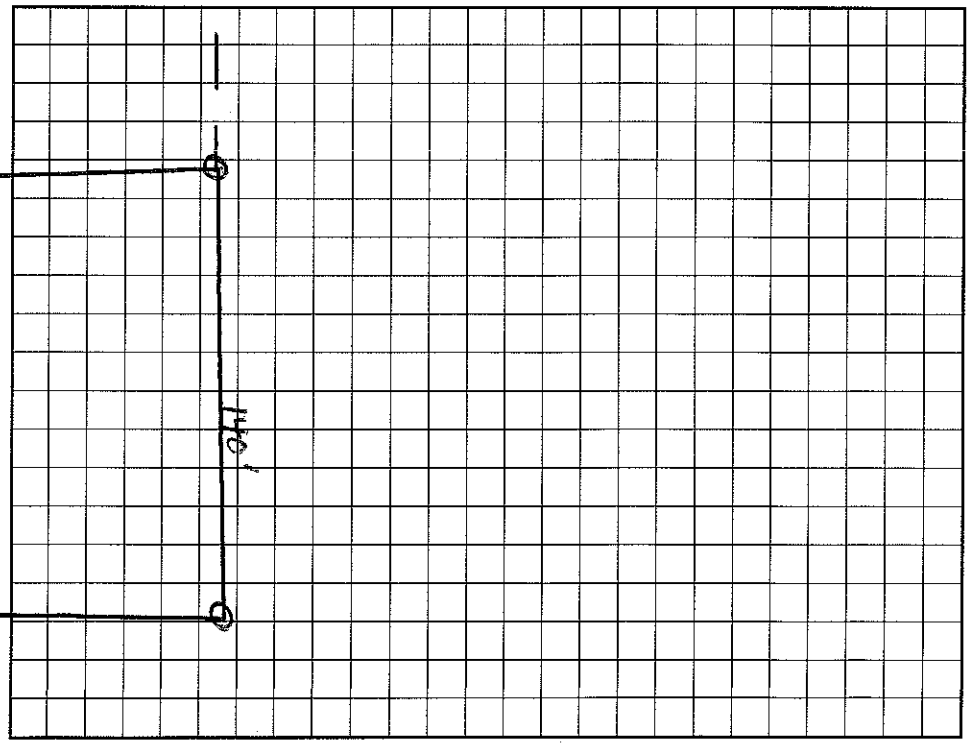


I understand that this permit can be suspended or revoked if any false information is supplied toward securing the permit/any unauthorized changes are made to the site/any unauthorized changes are made in the installation of the system. Improvement Permit with plat valid without expiration. Improvement Permit with site plan valid for sixty months. Authorization to Construct is valid for a period equal to that of Improvement Permit – not to exceed sixty months.

Signed: Peter C Lukas date _____ Installed by: F T Ennis

Improvement Permit by: C M Tezeno RS date 8/20/98 Operation Permit by: Wesley Sparks RS. date 4/24/00

Authorization to Construct by: C M Tezeno RS date 8/20/98 Existing System Inspection by: _____ date _____

HEALTH DEPT. COPY: WHITE INSPECTION COPY (FINAL): GREEN OWNER COPY (FINAL): YELLOW INSPECTION COPY (INITIAL): PINK OWNER COPY (INITIAL): GOLD