IREDELL COUNTY HEALTH DEPARTMENT

STATESVILLE 704-878-5305 MOORESVILLE 704-664-5281

IMPROVEMENT PERMIT / AUTHORIZATION TO CONSTRUCT / OPERATION PERMIT / EXISTING SYSTEM INSPECTION

PERMIT# 108850 PIN# 4655-15-8557 DATE 10/7/02

OWNER OR CONTRACTOR James Gamble PHONE: Business Home 704-896-8056

ADDRESS 169 Hobbs Ln. Mooresville NC 28115

LOCATION 1155, TL Hobbs Ln. at End.

SUBDIVISION BLOCK / SECTION LOT LOT AREA 10+AC SITE CLASS. PS DESIGN FLOW 240 L.T.A.R.

Septic Tank: Existing 1250 Gallons; STB Date

Pump Tank: Gallons; PT Date

Pump Make: Model Serial No.

Nitrification Field: No Fields Square Feet 900 Linear Feet 300

No Lines 3 Trench Width Max Trench Bottom Depth Gravel Depth

☐ New System ☐ Repair System Type: (I.) II. III. IV. V. VI

System Description: Existing Conventional

Repair System Description:

Maintenance Agreement Required: ☐ Yes ☐ No

☐ House/Mod. Home No. Bedrooms 2

☐ Mobile Home No. Bathrooms 2.5

☐ Business No. Employees

☐ Other

☐ Slab ☐ Crawl Space ☐ Basement w/plumbing ☐ Basement wo/plumbing

Water Supply: ☒ Individual ☐ Public ☐ Community

Comments:/Conditions:


Comments:/Conditions:

Removing Existing Bathroom - Adding 2 new bed rooms

INITIAL SITE SKETCH

AS BUILT SKETCH

Not to Scale

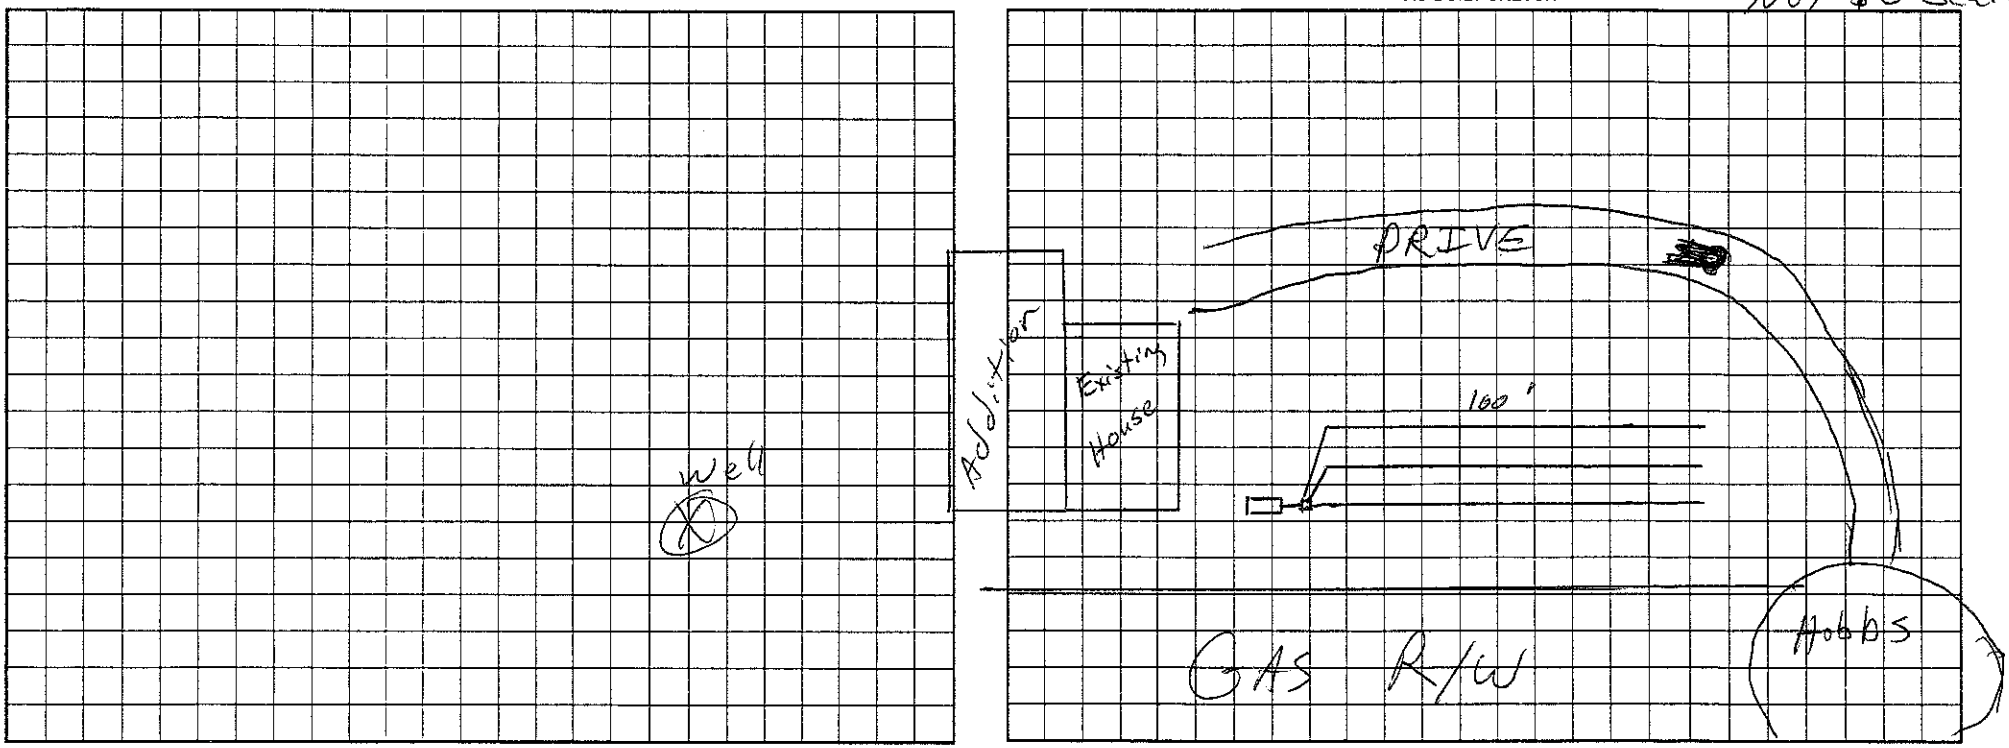

Permit can be suspended or revoked if any false information is supplied toward securing the permit/any unauthorized changes are made to the site/any unauthorized changes are made in the installation of the system. Improvement Permit with plat valid without expiration. Improvement Permit with site plan valid for sixty months. Authorization to Construct is valid for a period equal to that of Improvement Permit – not to exceed sixty months.

Signed: Kimberly H Gamble date

Improvement Permit by: date

Authorization to Construct by: date

Installed by:

Operation Permit by: date

Existing System Inspection by: BS date 10/7/02

HEALTH DEPT. COPY: WHITE OWNER COPY (FINAL): YELLOW OWNER COPY (INITIAL): PINK