IREDELL COUNTY HEALTH DEPARTMENT

Auth. To Construct

472-1806

STATESVILLE 704-878-5305 MOORESVILLE 704-664-5281

IMPROVEMENT PERMIT / CERTIFICATE OF COMPLETION / OPERATION PERMIT / EXISTING SYSTEM INSPECTION

PROPERTY DESCRIPTION NO. 25818 DATE 1/22/97 TAX MAP NO. 4655172971 Watershed: ☐ Yes ☐ No

OWNER OR CONTRACTOR Christopher Sprung PHONE: Business _____ Home 896-8408

ADDRESS Fairbrook Dr. Mooresville, NC 28115

LOCATION Faith Rd off 115-21 To Fairbrook Dr. straight in 1st drive on

SUBDIVISION Arrowridge BLOCK / SECTION _____ LOT 6 LOT AREA Empty SITE CLASS. PS 1 DESIGN FLOW 480 L.T.A.R. .3

Septic Tank: Existing Gallons; STB 321 Date 1-3-97

Pump Tank: _____ Gallons; PT _____ Date _____

Pump Make: _____ Model _____ Serial No. _____

Nitrification Field: No Fields 1 Square Feet 900 Linear Feet 300X

No Lines 3 Trench Width 36" Max Trench Bottom Depth 36" Gravel Depth SAND

☒ New System ☒ Repair System Type: I, II, III, IV, V, VI

System Description: X CH PLASTIC

Repair System Description: _____

Maintenance Agreement Required: ☐ Yes ☐ No

☒ House/Mod. Home No. Bedrooms 4

☐ Mobile Home No. Bathrooms 3

☐ Business No. Employees ____

☐ Other _____


☐ Slab ☒ Crawl Space ☐ Basement w/plumbing ☐ Basement wo/plumbing

Water Supply: ☒ Individual ☐ Community ☐ Public

Comments: Set 6 hole Dist Box, cut top existing line of system, add 3 lines 100' x 3' of Chambered Plastic - install on contour in direction shown

Comments:

INITIAL SITE SKETCH

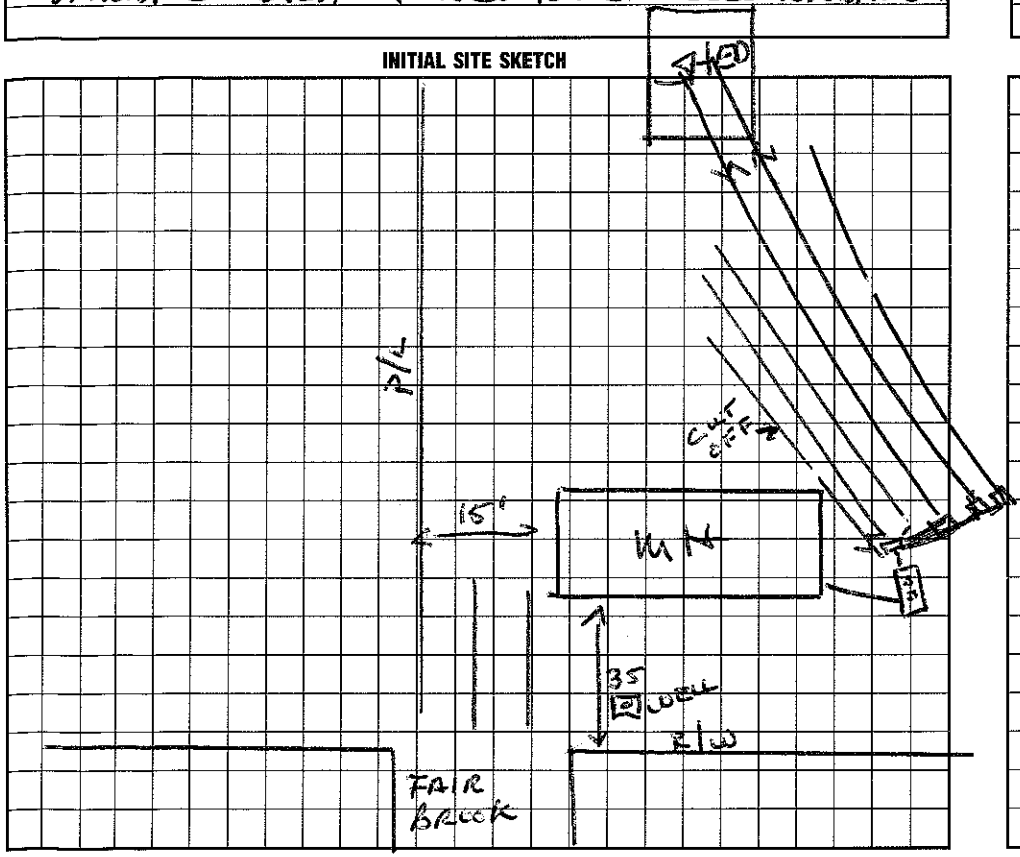

AS BUILT SKETCH

I understand that this permit can be suspended or revoked if any false information is supplied toward securing the permit/any unauthorized changes are made to the site/any unauthorized changes are made in the installation of the system.

Signed: Left on front door.

Improvement Permit by: Wesley Sparks RS. date 1/22/97

Existing System Inspection by: Wesley Sparks RS. date 1/22/97

Installed by: B+M Enterprises

Certificate of Completion by: Wesley Sparks RS date 2/11/97

Operation Permit by: Wesley Sparks RS date 2/11/97

HEALTH DEPT. COPY: WHITE INSPECTION COPY (FINAL): GREEN OWNER COPY (FINAL): YELLOW INSPECTION COPY (INITIAL): PINK OWNER COPY (INITIAL): GOLD