162 Faith Rd. 2005 owner Charles Kaiser Gravity (3:30)

IREDELL COUNTY HEALTH DEPARTMENT

STATESVILLE 704-878-5305 MOORESVILLE 704-664-5281

IMPROVEMENT PERMIT / AUTHORIZATION TO CONSTRUCT / OPERATION PERMIT / EXISTING SYSTEM INSPECTION

PERMIT# REPAIR PIN# REPAIR 4655 17 8339 DATE 3/2/99

OWNER OR CONTRACTOR MICHAEL MELECIA PHONE: Business Home 592-6134

ADDRESS 164 FAITH RD 162 Faith Rd

LOCATION 115 S. TL FAITH RD - ON RT

SUBDIVISION BLOCK / SECTION — LOT — LOT AREA — .46Ac SITE CLASS. IVS DESIGN FLOW 360 L.T.A.R. —

Septic Tank: 1000/1500 Gallons; STB 709 Date

Pump Tank: Gallons; PT Date

Pump Make: Model Serial No.

Nitrification Field: No Fields 1 Square Feet 600 Linear Feet 200

No Lines 4@50' Trench Width 36" Max Trench Bottom Depth 36" Gravel Depth N/A

☐ New System ☑ Repair System Type: I, II, III, IV, V, VI

System Description: GRAVITY CHAMBERS

Repair System Description: 6 BEDS

Maintenance Agreement Required: ☐ Yes ☐ No

☑ House/Mod. Home ☐ Mobile Home ☐ Business ☐ Other

No. Bedrooms 3 No. Bathrooms 2 No. Employees

☐ Slab ☐ Crawl Space ☐ Basement w/plumbing ☐ Basement wo/plumbing


Water Supply: ☑ Individual ☐ Public ☐ Community

Comments:/Conditions: (NO SCALE)

4 @ 50' Conventional
@ 50' Chambers

Comments:/Conditions:

INITIAL SITE SKETCH

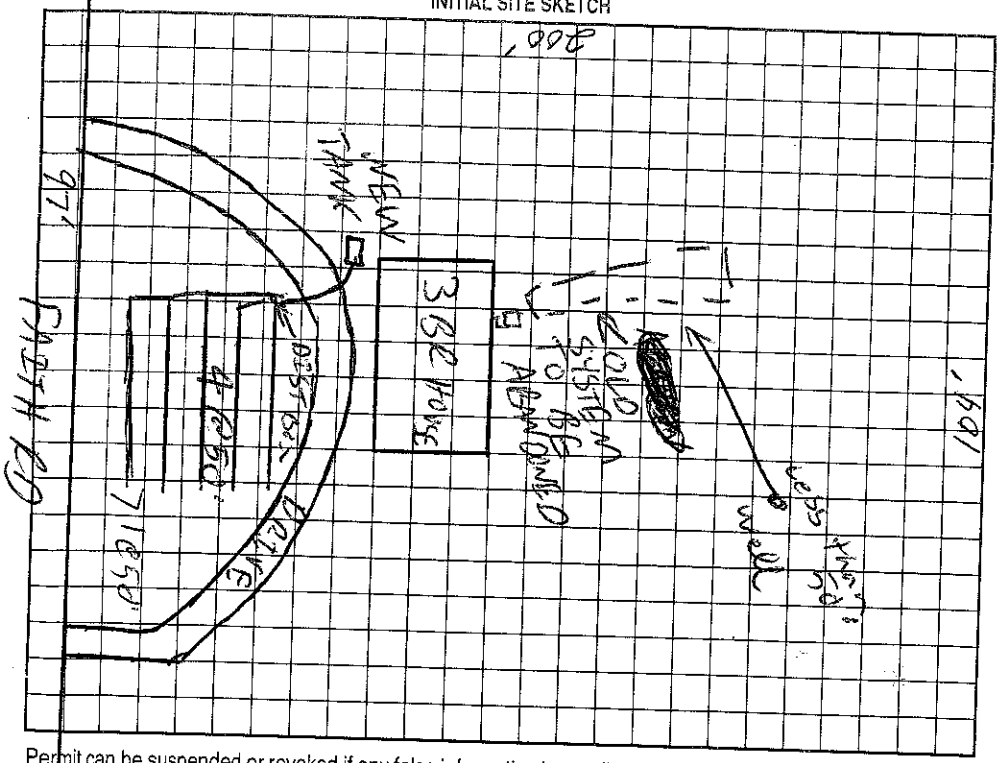

AS BUILT SKETCH

Permit can be suspended or revoked if any false information is supplied toward securing the permit/any unauthorized changes are made to the site/any unauthorized changes are made in the installation of the system. Improvement Permit with plat valid without expiration. Improvement Permit with site plan valid for sixty months. Authorization to Construct is valid for a period equal to that of Improvement Permit – not to exceed sixty months.

Signed: date 3/4/99

Improvement Permit by: C. Myers KS date 3/2/99

Authorization to Construct by: C. Myers KS date 3/2/99

Installed by: MICHAEL MELECIA

Operation Permit by: C. Myers KS date 3/11/99

Existing System Inspection by: date

HEALTH DEPT. COPY: WHITE OWNER COPY (FINAL): YELLOW OWNER COPY (INITIAL): PINK