IREDELL COUNTY HEALTH DEPARTMENT

Authorization to Construct

STATESVILLE 704-878-5305 MOORESVILLE 704-664-5281

IMPROVEMENT PERMIT / ~~CERTIFICATE OF COMPLETION~~ / OPERATION PERMIT / EXISTING SYSTEM INSPECTION

PROPERTY DESCRIPTION NO. 13866 DATE 10/30/96 TAX MAP NO. 2H 8A 121 + 122 Watershed: ☐ Yes ☒ No

OWNER OR CONTRACTOR Joe Phelps PHONE: Business Home 4655 18 8324 Lot 121

ADDRESS Fremont Park Loop 4655187294 Lot 122

LOCATION Fremont Lp. - Fifth Rd. To Fremont Loop (1st) bottom hill, 1st lots on (L)

SUBDIVISION Fremont Park BLOCK / SECTION 2 LOT 121 + 122 LOT AREA 1 ~ 3/4 ACRE SITE CLASS. P/S DESIGN FLOW 360 L.T.A.R. .3

Septic Tank: 1000 Gallons; STB 794 Date 8/29/96

Pump Tank: 1000 Gallons; PT 27 Date 9/22/96

Pump Make: Gouldes Model WE07T2H Serial No. T9603115

Nitrification Field: No Fields 1 Square Feet 1200 Linear Feet 400

No Lines 4 Trench Width 36" Max Trench Bottom Depth 24-26" Gravel Depth

☒ New System ☐ Repair System Type: I, II, (III) IV, V, VI

System Description: PumMan → CONV

Repair System Description: APBS 16"

Maintenance Agreement Required: ☐ Yes ☒ No

☒ Slab ☒ Crawl Space ☐ Basement w/plumbing ☐ Basement wo/plumbing

☒ House/Mod. Home No. Bedrooms 3

☐ Mobile Home No. Bathrooms 3

☐ Business No. Employees

☐ Other


Water Supply: ☒ Individual ☐ Community ☐ Public

Comments:

Comments:

INITIAL SITE SKETCH

AS BUILT SKETCH

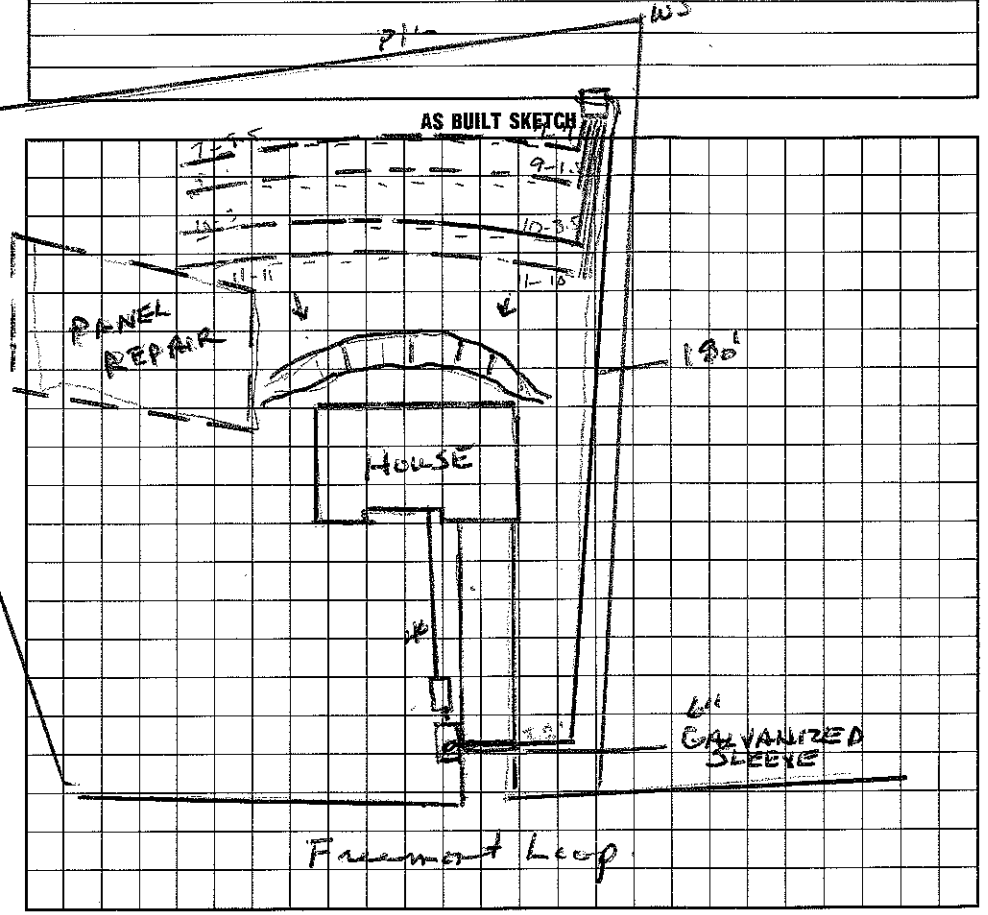

I understand that this permit can be suspended or revoked if any false information is supplied toward securing the permit/any unauthorized changes are made to the site/any unauthorized changes are made in the installation of the system.

Signed:

Improvement Permit by: date

~~Existing System Inspection~~ by: Wesley Speed R.S. date 5/22/97

Installed by: P.J. Erwin

Certificate of Completion by: Wesley Speed R.S. date 5/22/97

Operation Permit by: Wesley Speed R.S. date 5/22/97

HEALTH DEPT. COPY: WHITE INSPECTION COPY (FINAL): GREEN OWNER COPY (FINAL): YELLOW INSPECTION COPY (INITIAL): PINK OWNER COPY (INITIAL): GOLD