Old #123747

IREDELL COUNTY HEALTH DEPARTMENT

Statesville Office (704) 878-5305 Mooresville Office (704) 660-3625 PERMIT # 201999

IMPROVEMENT PERMIT / AUTHORIZATION TO CONSTRUCT / OPERATION PERMIT / EXISTING SYSTEM

PIN # 4655-18-8444

APPLICANT: Emil Bec APPLICANT ADDRESS: 225 Mott Rd Mooresville NC

SITE ADDRESS: 143 Fremont Lp Mooresville NC PHONE: 704-526-7115 ALT. PHONE:

SITE DIRECTIONS: S on Mecklenburg Hwy (Hwy 115), TL on Fair Rd, TL on Fremont Lp, Lot on L


SUBDIVISION: Fremont Park SECTION: 2 LOT # 120 LOT AREA: 0.60ac DESIGN FLOW: 480 L.T.A.R.: 0.25

Septic Tank	1000 (gal)	STB	825	Date	12-6-14	☑ New System ☐ Repair ☐ Expansion	System Type: I II III IV V VI	☑ Residence	No. Bedrooms 4
Pump Tank	1000 (gal)	PT	302	Date	10-12-14	System Description: PM 25% Reduction		☐ Business	No. Persons 8
Pump Make		Model		Serial #		Repair System Description: Repair Exempt, Plat recorded 7-24-1974		☐ Other	No. Employees
# Nitrification Fields	1	# Lines	6	Linear Ft:	484	Maintenance Agreement Required: ☐ YES ☑ NO		☐ Slab	☑ Crawl Space
Trench Width	36"	Max. Trench Bottom Depth	16"	Gravel Depth	N/A	☐ GRAVITY ☑ PRESSURE		☐ Basement w/plumbing	☐ Basement w/o plumbing

Water Supply: ☐ Private ☐ Public ☑ Community

Comments / Conditions: * Repair Exempt * Plat recorded July 24, 1974, Also may go within 5ft of property line with drainlines if needed.

INITIAL SITE SKETCH

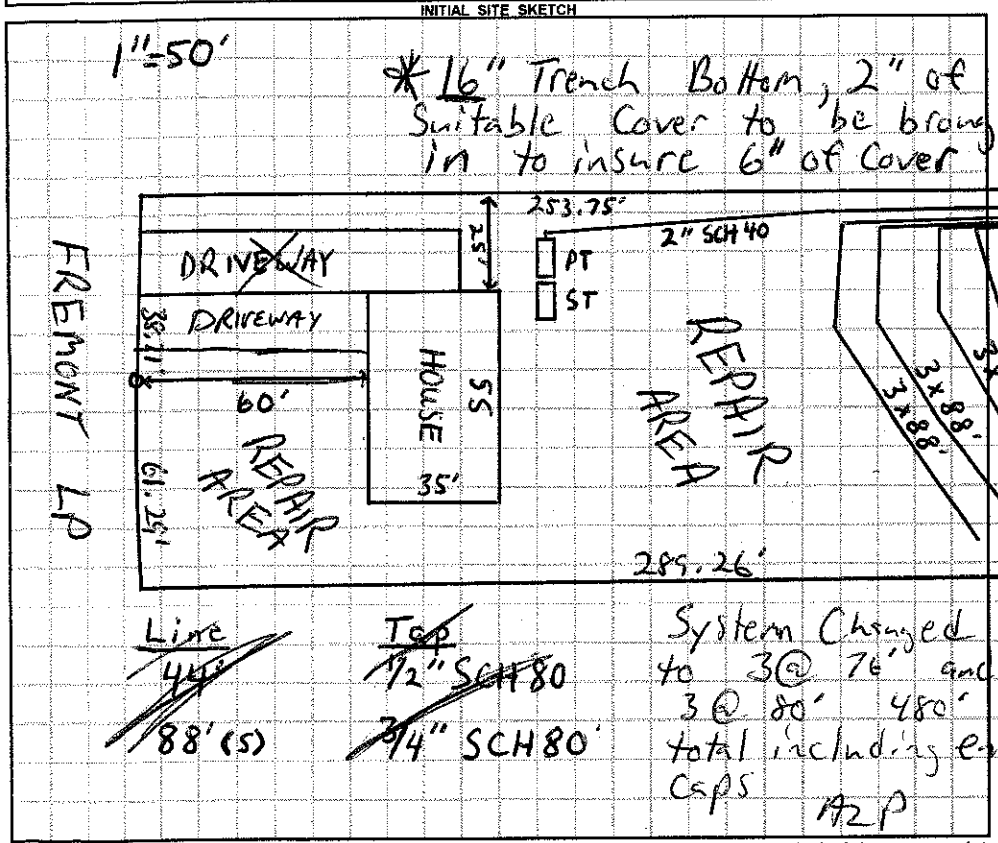

AS BUILT SKETCH

2670' Top 2
4680 Bottom 4
CHECKED LINES, TANKS, SET 2' PM

Permit can be suspended or revoked if any false information is supplied toward securing this permit / any unauthorized changes are made to the site / any unauthorized changes are made in the installation of the system. **CONTACT A LOCATOR SERVICE PRIOR TO ANY EXCAVATION**

☐ **IMPROVEMENT PERMIT** *with plat valid without expiration.* ☐ **IMPROVEMENT PERMIT** *with site plan valid for 60 mos.* ☒ **AUTHORIZATION TO CONSTRUCT** *valid for period equal to IMPROVEMENT PERMIT--not to exceed 60 mo.*

Owner / Applicant Signature: Date: 4-14-14 Installed by: Rowan Septic

IMPROVEMENT PERMIT by: Date: 4-11-14 OPERATION PERMIT by: RS Date: 5/29/15

AUTHORIZATION TO CONSTRUCT by: Date: APPROVED JUN 10 2014 Existing System Inspected by: Date:

Health Dept. Copy - WHITE Applicant (Final Approval) - YELLOW Applicant (Conditional Approval) - PINK