IREDELL COUNTY HEALTH DEPARTMENT

STATESVILLE 704-878-5305 MOORESVILLE 704-664-5281

IMPROVEMENT PERMIT / AUTHORIZATION TO CONSTRUCT / OPERATION PERMIT / EXISTING SYSTEM INSPECTION

PERMIT# Repair PIN# 4655201597 DATE 10/6/08

OWNER OR APPLICANT Knox Realty PHONE: Business 704-892-0196 Home same

ADDRESS P.O. Box 40 Davidson, NC 28036

LOCATION 1845 mecklenburg Hwy, 115, on lft past Butler & Barnes

SUBDIVISION _____ BLOCK / SECTION _____ LOT _____ LOT AREA 7+ acres SITE CLASS. P.S. DESIGN FLOW 360 L.T.A.R. 0.3

Septic Tank: existing Gallons: STB existing Date existing

Pump Tank: _____ Gallons: PT _____ Date _____

Pump Make: _____ Model _____ Serial No. _____

Nitrification Field: No Fields 1 Square Feet 1200 Linear Feet 300

No Lines 3 Trench Width 36" Max Trench Bottom Depth 36" Gravel Depth _____

☐ New System ☑ Repair ☐ Expansion System Type: I II III IV V VI

System Description: 25% reduction

Repair System Description: 25% reduction

Maintenance Agreement Required: ☐ Yes ☐ No

☑ House/Mod. Home No. Bedrooms 3

☐ Mobile Home No. Persons _____

☐ Business No. Employees _____

☐ Other _____


Water Supply: ☑ Individual ☐ Public ☐ Community

☑ Gravity ☐ Pressure ☐ Slab ☑ Crawl Space ☐ Basement w/plumbing ☐ Basement wo/plumbing

Comments:/Conditions:

Comments:/Conditions:

INITIAL SITE SKETCH

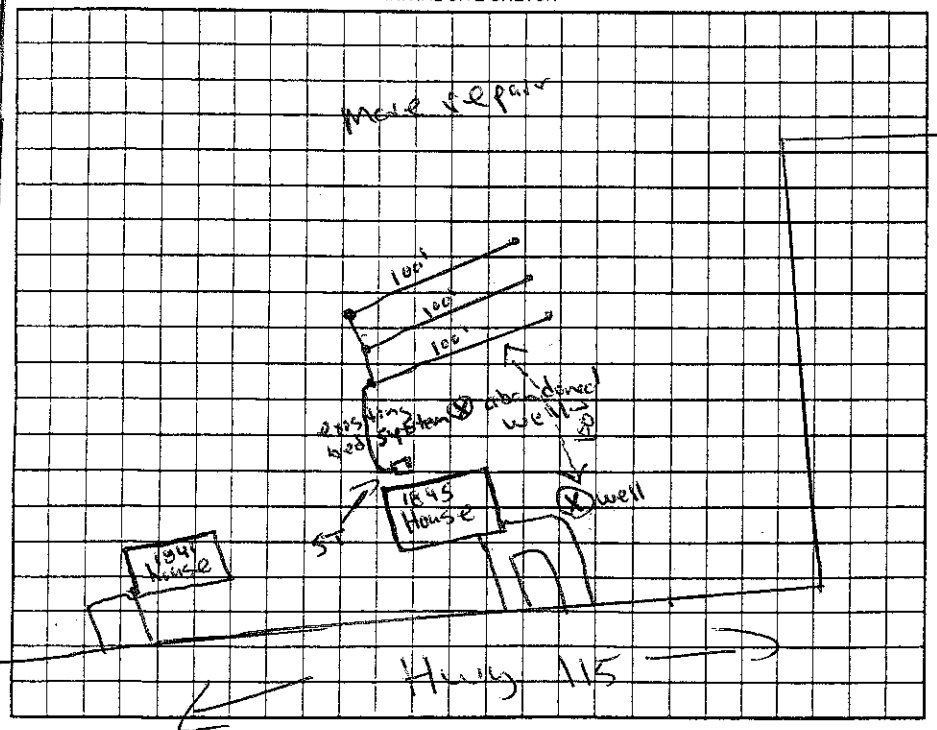

AS BUILT SKETCH

Permit can be suspended or revoked if any false information is supplied toward securing the permit/any unauthorized changes are made to the site/any unauthorized changes are made in the installation of the system. Improvement Permit with plat valid without expiration ☐ Improvement Permit with site plan valid for sixty months ☑ Authorization to Construct is valid for a period equal to that of Improvement Permit – not to exceed sixty months.

Signed: [redacted] date 10.6.08 Installed by: A-1 Backhoe

Improvement Permit by: Randy Moore date 10/06/08 Operation Permit by: Randy Moore date 10/06/08

Authorization to Construct by: Randy Moore date 10/06/08 Existing System Inspection by: _____ date _____

HEALTH DEPT. COPY: WHITE OWNER COPY (FINAL): YELLOW OWNER COPY (INITIAL): PINK