IREDELL COUNTY HEALTH DEPARTMENT

STATESVILLE 704-878-5305 MOORESVILLE 704-664-3281

IMPROVEMENT PERMIT / AUTHORIZATION TO CONSTRUCT / OPERATION PERMIT / EXISTING SYSTEM INSPECTION

PERMIT# No PIN# 4655 23 0104 DATE 6/16/99

OWNER OR CONTRACTOR James Davis PHONE: Business Home 892-6655

ADDRESS 184 Eastport Lane Mooresville, NC. 28115

LOCATION 115 S TL Eastport TR at stop sign to 4th house on (R)

SUBDIVISION No BLOCK / SECTION LOT LOT AREA EXISTING SITE CLASS. DESIGN FLOW 360 L.T.A.R.

Septic Tank: Gallons; STB Date

Pump Tank: Gallons; PT Date

Pump Make: Model Serial No.

Nitrification Field: No Fields 1 Square Feet 800 Linear Feet 160

No Lines 2 Trench Width 10' Max Trench Bottom Depth 48" Gravel Depth 12"

☐ New System ☒ Repair System Type: I, (II), III, IV, V, VI

System Description:

Repair System Description: 80'x10' Bed.

Maintenance Agreement Required: ☐ Yes ☒ No

☒ House/Mod. Home No. Bedrooms 3

☐ Mobile Home No. Bathrooms 2

☐ Business No. Employees


☐ Other

☐ Slab ☒ Crawl Space ☐ Basement w/plumbing ☐ Basement wo/plumbing

Water Supply: ☒ Individual ☐ Public ☐ Community

Comments:/Conditions:

INITIAL SITE SKETCH

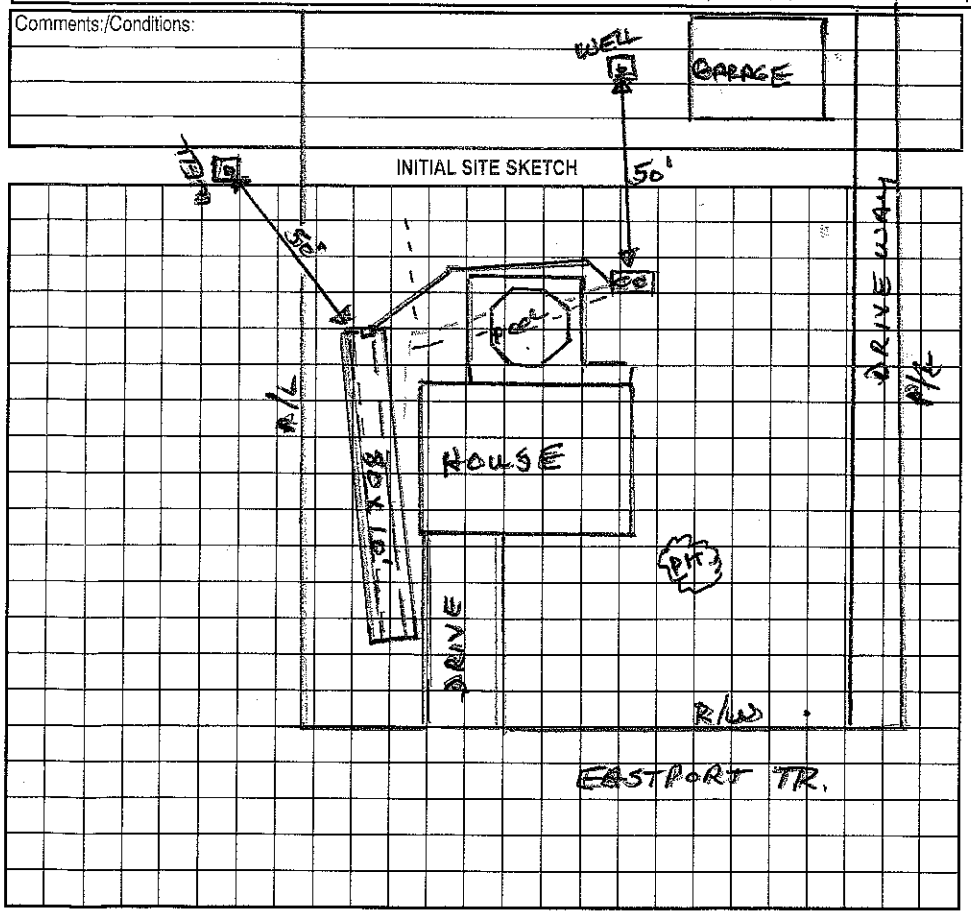

Comments:/Conditions:

AS BUILT SKETCH

Permit can be suspended or revoked if any false information is supplied toward securing the permit/any unauthorized changes are made to the site/any unauthorized changes are made in the installation of the system. Improvement Permit with plat valid without expiration. Improvement Permit with site plan valid for sixty months. Authorization to Construct is valid for a period equal to that of Improvement Permit – not to exceed sixty months.

Signed: * James Davis date 6-23-99

Installed by: Seymon Const. Co.

Improvement Permit by: Wesley Sparks R.S. date 6/16/99

Operation Permit by: Wesley Sparks R.S. date 7/20/99

Authorization to Construct by: Wesley Sparks R.S. date 6/16/99

Existing System Inspection by: date

HEALTH DEPT. COPY: WHITE OWNER COPY (FINAL): YELLOW OWNER COPY (INITIAL): PINK