4655 234947

IREDELL COUNTY HEALTH DEPARTMENT

STATESVILLE 704-878-5305 MOORESVILLE 704-664-5281

IMPROVEMENT PERMIT / CERTIFICATE OF COMPLETION / OPERATION PERMIT / EXISTING SYSTEM INSPECTION

PROPERTY DESCRIPTION NO. 15007 DATE 6/18/93 TAX MAP NO. 2A C 10

OWNER OR CONTRACTOR PEGGY ORBISON PHONE: Business Home 663-3208

ADDRESS Eastpoint Dr. Mooresville, NC.

LOCATION 7155, TL on Eastpoint Dr, TR on Eastpoint Dr. (L) where gravel starts to 2nd drive on (L)

SUBDIVISION N/A BLOCK / SECTION N/A LOT LOT AREA ~ 3.5 ACRES SITE CLASS. P L.T.A.R. .25-.3

Water Supply: ☑ Individual ☐ Community ☐ Public

Septic Tank: 1000 Gallons; STB 782 Date 10/6/93

Pump Tank: Gallons; PT Date

Nitrification Field: No Fields 1 Square Feet 1200 Linear Feet 400

No Lines 4 Trench Width 36" Trench Depth 36" Gravel Depth 12"

☑ New System ☐ Repair System Type: I, II, III, IV, V, VI

System Description: CONV - DRIP BOX

Repair System Description: CONV.

Maintenance Agreement Required: ☐ Yes ☑ No

☑ House/Mod. Home No. Bedrooms 3 Garbage Disposal: ☐ Yes ☑ No

☐ Mobile Home No. Bathrooms 2 Auto. Dishwasher: ☑ Yes ☐ No


☐ Business No. Employees Auto. Washing Machine: ☑ Yes ☐ No

☐ Other Other

☐ Slab ☑ Crawl Space ☐ Basement w/plumbing ☐ Basement wo/plumbing

Comments RE-ISSUE OF OLD PERMIT - HOUSE LOCATION SHIFTED.

INITIAL SITE SKETCH

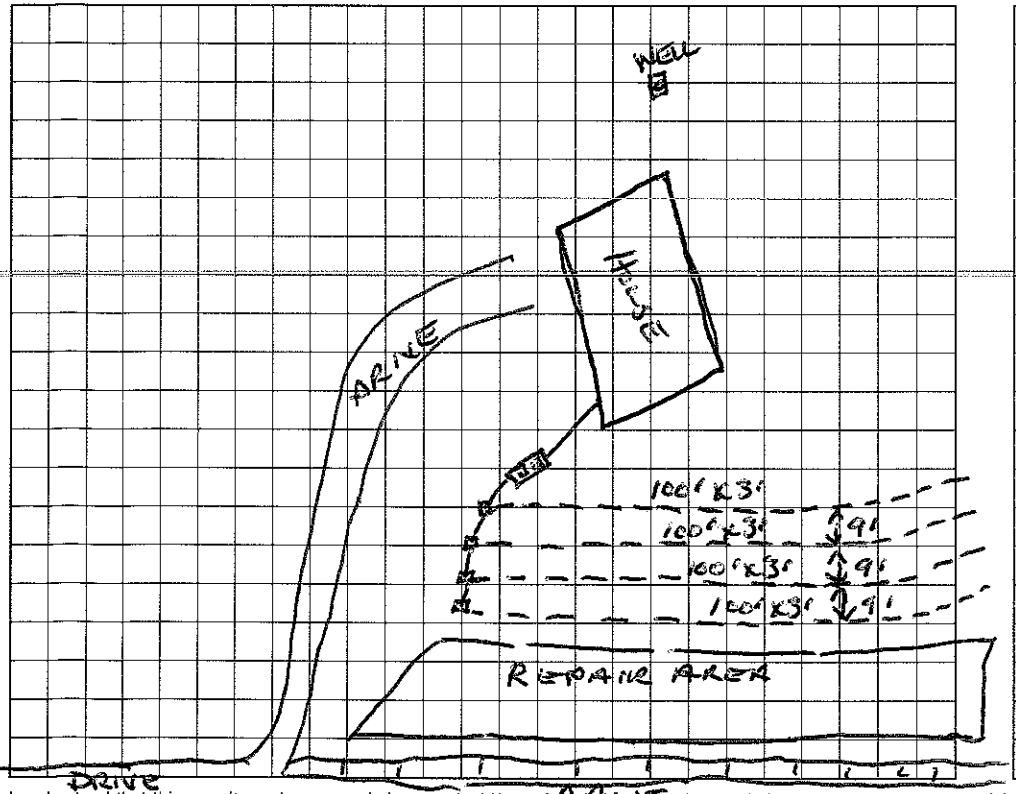

AS BUILT SKETCH

Installed as shown.

I understand that this permit can be suspended or revoked if any false information is supplied toward securing the permit/any unauthorized changes are made to the site/any unauthorized changes are made in the installation of the system. Improvement Permit is valid for 60 months from date of issuance.

Signed:

Improvement Permit by: Wesley Sparks R.S. date 6/13/93

Existing System Inspection by: date

Installed by: Donald Orbison

Certificate of Completion by: Wesley Sparks R.S. date 4/5/94

Operation Permit by: date

HEALTH DEPT. COPY: WHITE INSPECTION COPY (FINAL): GREEN OWNER COPY (FINAL): YELLOW INSPECTION COPY (INITIAL): PINK OWNER COPY (INITIAL): GOLD