IREDELL COUNTY HEALTH DEPARTMENT

→ Authorization to Construct

STATESVILLE 704-878-5305 MOORESVILLE 704-664-5281

IMPROVEMENT PERMIT / ~~CERTIFICATE OF COMPLETION~~ / OPERATION PERMIT / EXISTING SYSTEM INSPECTION

PROPERTY DESCRIPTION NO. 22049 DATE 10/18/95 TAX MAP NO. 2A C 1D

OWNER OR CONTRACTOR Peggy Jane Orbison PHONE: Business _____ Watershed: ☐ Yes ☒ No

ADDRESS 109 Echo Hill RD. Mooresville, NC. Home 896-0674

LOCATION Mecklenburg Hwy TL Eastpoint Tn. (R) Eastpoint Ln. TL Echo Ln. 1st Trailer on (L) past pond

SUBDIVISION N/A BLOCK / SECTION _____ LOT N/A LOT AREA ~2.2 Ac SITE CLASS. PS DESIGN FLOW 360 L.T.A.R. .2

Septic Tank: 1000 Gallons; STB 825 Date 12/09/99

Pump Tank: _____ Gallons; PT _____ Date _____

Pump Make: _____ Model _____ Serial No. _____

Nitrification Field: No Fields 1 Square Feet 1800 Linear Feet 600

No Lines 4 Trench Width 36" Max Trench Bottom Depth 28" Gravel Depth 12"

☒ New System ☐ Repair System Type: I, II, III, IV, V, VI

System Description: Dipper Box - Conventional

Repair System Description: Panel

Maintenance Agreement Required: ☐ Yes ☒ No

☒ House/Mod. Home No. Bedrooms 3

☐ Mobile Home No. Bathrooms 2

☐ Business No. Employees _____

☐ Other _____

☐ Slab ☐ Crawl Space ☒ Basement w/plumbing ☐ Basement wo/plumbing

Water Supply: ☒ Individual ☐ Community ☐ Public Shown

Comments:


28" Trench bottom - Contours important

Dipper Box to 2 Dist Boxes - 2 lines per Dist Box


Comments:

WELL

INITIAL SITE SKETCH

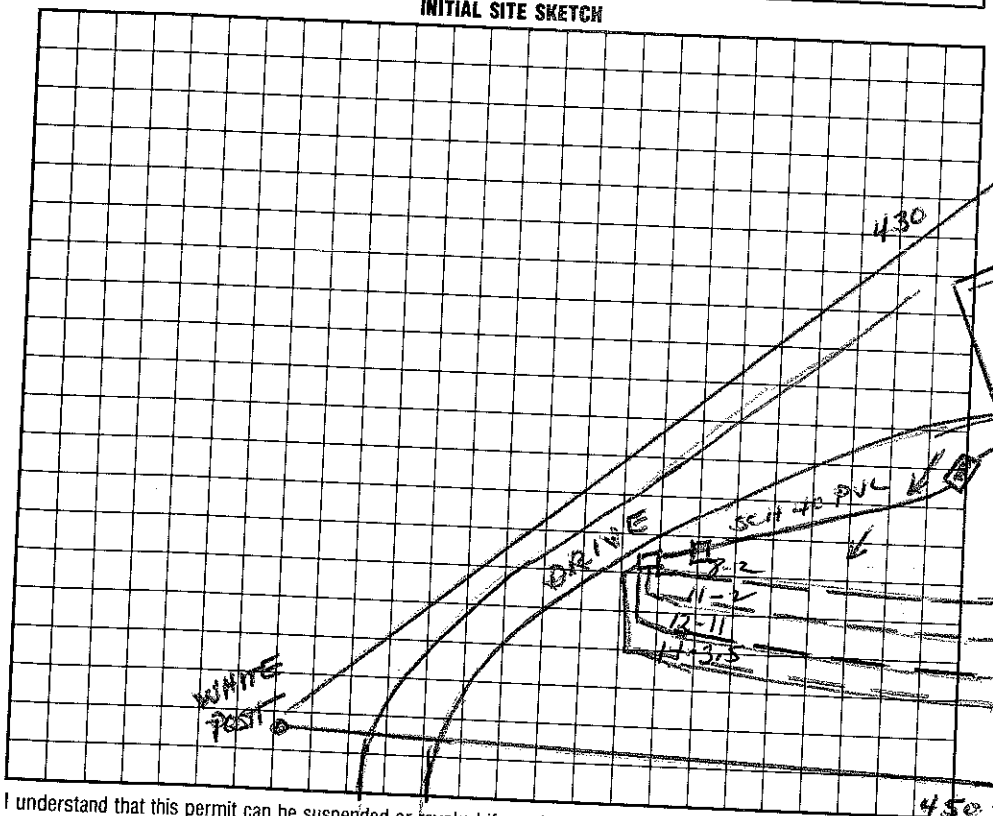

AS BUILT SKETCH

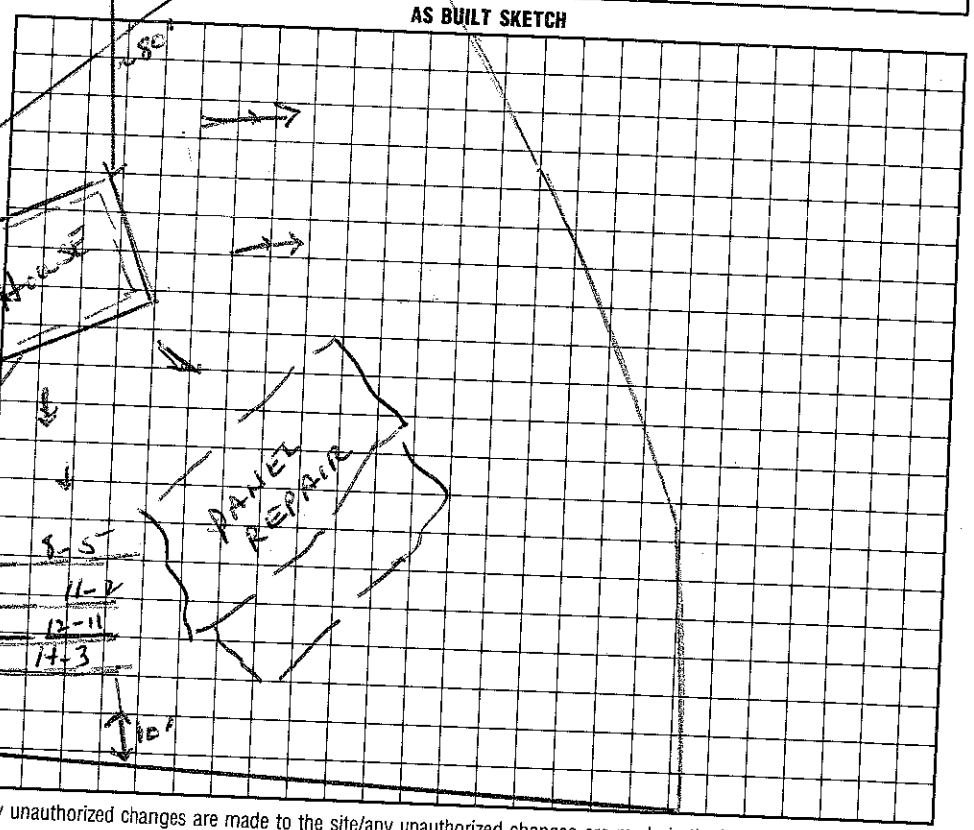

I understand that this permit can be suspended or revoked if any false information is supplied toward securing the permit/any unauthorized changes are made to the site/any unauthorized changes are made in the installation of the system.

Signed: Peggy T. Orbison

Improvement Permit by: Wesley Sparks RS. date 10/18/95

~~Existing System Inspection by:~~ Authorization to Construct Wesley Sparks RS date 10/18/95

Installed by: Daryl Orbison Certificate of Completion by _____ date _____

Operation Permit by: Wesley Sparks RS. date 10/19/00

HEALTH DEPT. COPY: WHITE INSPECTION COPY (FINAL): GREEN OWNER COPY (FINAL): YELLOW INSPECTION COPY (INITIAL): PINK OWNER COPY (INITIAL): GOLD