IREDELL COUNTY HEALTH DEPARTMENT

STATESVILLE 704-878-5305 ∅ MOORESVILLE 704-664-5281

IMPROVEMENT PERMIT / AUTHORIZATION TO CONSTRUCT / OPERATION PERMIT / EXISTING SYSTEM INSPECTION

PERMIT# 127979 PIN# 4655-23-9237.228 4655 23 9270 DATE 7/8/05

OWNER OR CONTRACTOR ~~Blake Fox~~ / Teresa Miller PHONE: Business 704 883 2365 Home

ADDRESS 106 Wickford Ln Mooresville NC 28117

LOCATION 115 S, TL Eastport, TR Eastport on Rt 226 Eastport Ln.

SUBDIVISION — BLOCK / SECTION — LOT 2 LOT AREA 1.026 AC SITE CLASS PS DESIGN FLOW 480 L.T.A.R. 0.3

Septic Tank: 1000 Gallons; STB 100 Date 2/6/07
Pump Tank: 1000 Gallons; PT 274 Date 2/13/07
Pump Make: — Model — Serial No. —
Nitrification Field: No Fields 1 Square Feet 1700 Linear Feet 400
No Lines 6@67' Trench Width 36" Max Trench Bottom Depth 36" Gravel Depth —

☒ New System ☐ Repair System Type: I II III IV V VI
System Description: ~~Conv.~~ → 25% Reduct. Conv. Same
Repair System Description:
Maintenance Agreement Required: ☐ Yes ☒ No

☒ House/Mod. Home Duplex No. Bedrooms 4
☐ Mobile Home No. Bathrooms —
☐ Business No. Employees —
☐ Other —


☒ Slab ☐ Crawl Space ☐ Basement w/plumbing ☐ Basement wo/plumbing

Water Supply: ☒ Individual ☐ Public ☐ Community

Comments:/Conditions:
1"=50'

Comments:/Conditions:
* Pump → 25% Reduction due to grading change and H.D. approval - JCA 5/24/07

INITIAL SITE SKETCH

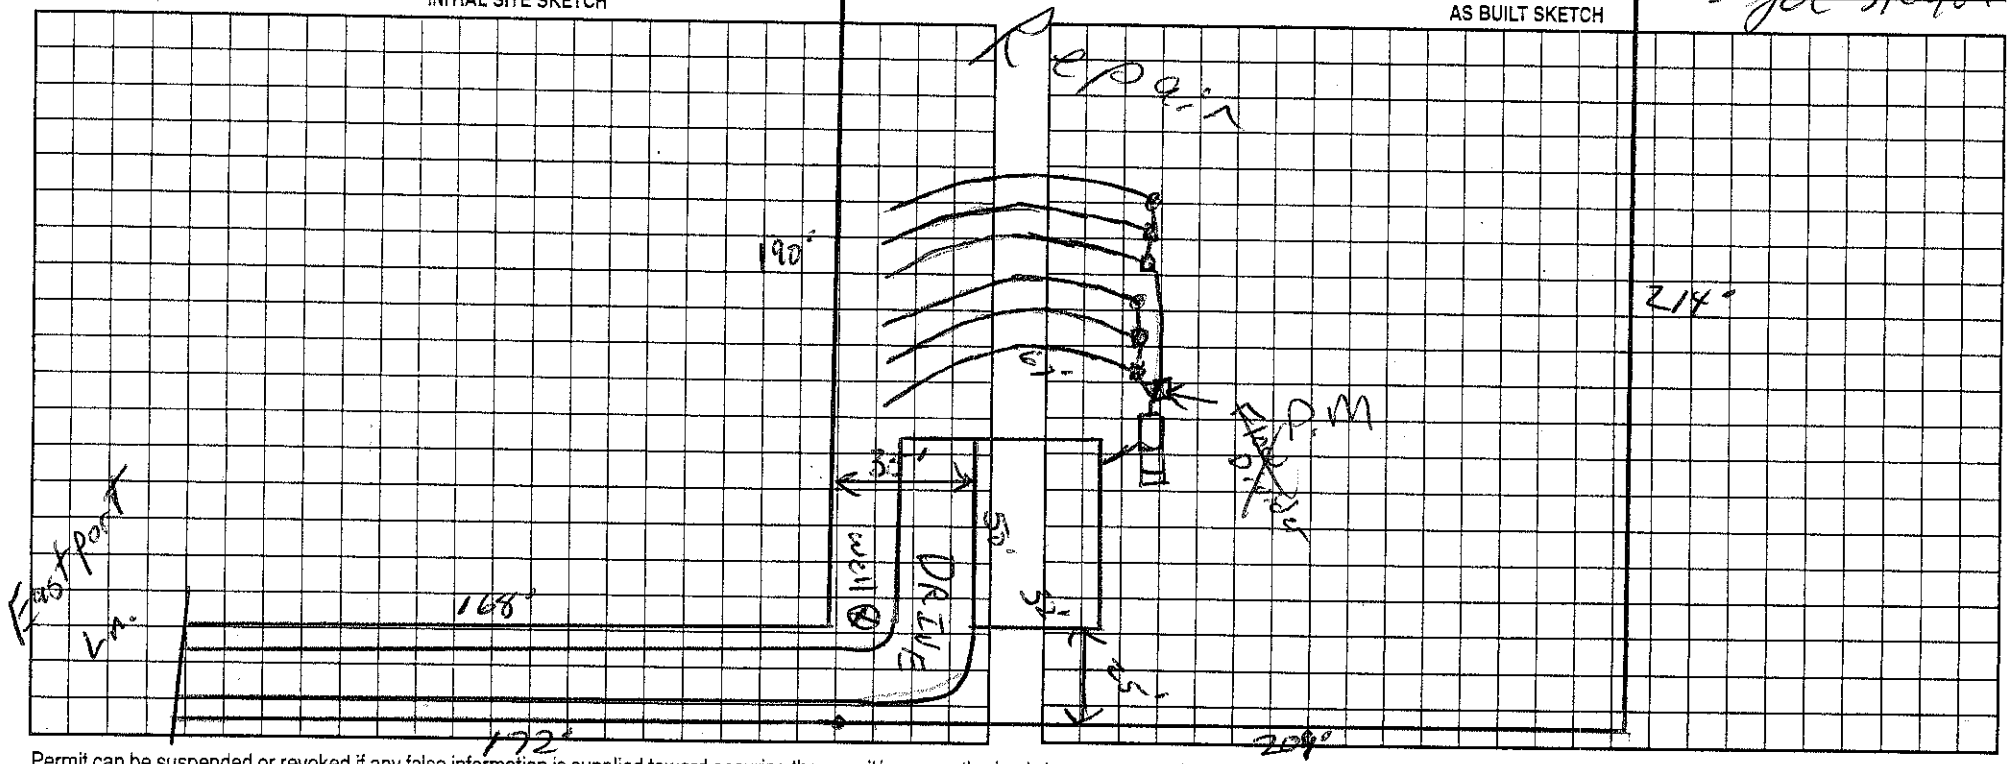

AS BUILT SKETCH

Permit can be suspended or revoked if any false information is supplied toward securing the permit/any unauthorized changes are made to the site/any unauthorized changes are made in the installation of the system. Improvement Permit with plat valid without expiration. Improvement Permit with site plan valid for sixty months. Authorization to Construct is valid for a period equal to that of Improvement Permit – not to exceed sixty months.

Signed: [signature] date 7-13-05 Installed by: Steve Jarrett Grading

Improvement Permit by: [signature] RS date 7/8/05 Operation Permit by: [signature] RS. date 6/14/07

Authorization to Construct by: [signature] RS date 7/8/05 Existing System Inspection by: — date —

HEALTH DEPT. COPY: WHITE OWNER COPY (FINAL): YELLOW OWNER COPY (INITIAL): PINK