IREDELL COUNTY HEALTH DEPARTMENT

Statesville Phone TR 3-7271 Mooresville Phone NO 3-1271

PERMIT TO INSTALL SEPTIC TANK

Permit No. _____ Permit Date 15 July 1964

Owner Hope Bros Builders Inc Address Statesville

Installed By Hoke Address Statesville

Location of Property Freedom Park


Lot 22.

Tank		Capacity		Length of Lines		Fixtures	
Block	( )	1000	(✓)	225'	( )	No. of Baths	( )
Precast	(X)	1250	( )	250'	( )	Dishwasher	( )
		1500	( )	Other 350		Garbage Grdr.	( )
		Other _____				Other _____	

NOTIFY HEALTH DEPARTMENT AT LEAST EIGHT HOURS BEFORE TANK IS TO BE INSPECTED.

Final Inspection 15 July 1964 Approved (X) Disapproved ( )

Remarks Community well

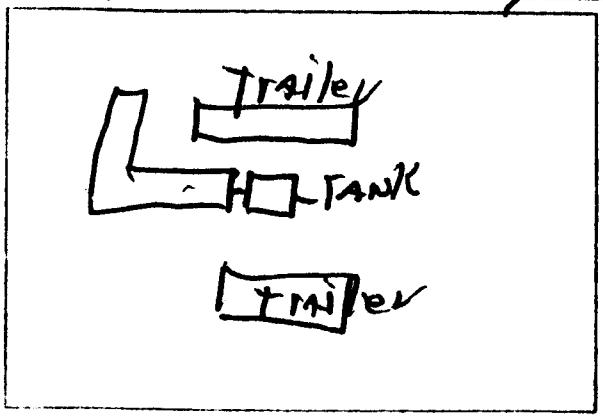

Sketch of Installation

Sanitarian