IREDELL COUNTY HEALTH DEPARTMENT

Statesville Phone TR 3-7271 Mooresville Phone No. 664-5281

PERMIT TO INSTALL SEPTIC TANK

Permit No. 62 Permit Date 4-20- 1973

Owner Hope Bros. Address Statesville

Installed By " Address "


Location of Property 115 S To on 1136 ¼ on left Freemont Park House no. 21.

Tank		Capacity		Length of Lines		Fixtures	
Block	(X)	1000	(✓)	225'	( )	No. of Baths	(3)
Precast	(X)	1250	( )	250'	( )	Dishwasher	( )
		1500	( )	Other 240'		Garbage Grdr.	( )
		Other				Other washing machine	

NOTIFY HEALTH DEPARTMENT AT LEAST EIGHT HOURS BEFORE TANK IS TO BE INSPECTED.

Final Inspection 4-20- 1973 Approved (✓) Disapprcved ( )

Remarks Community well

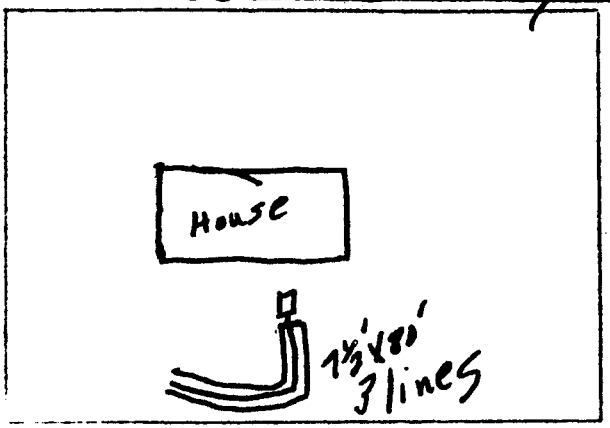

Sketch of Installation

J. C. Moore

Sanitarian