IREDELL COUNTY HEALTH DEPARTMENT

Statesville Phone TR 3-7271 Mooresville Phone No. 664-5281

PERMIT TO INSTALL SEPTIC TANK

Permit No. 7 Permit Date 1-17-1973

Owner Hope Brothers Address Statesville

Installed By " Address "


Location of Property N.C. 115 S to left on 1136 ½mi Then left into Freemont Park Lot no 3.

Tank		Capacity		Length of Lines		Fixtures	
Block	( )	1000	(✓)	225'	( )	No. of Baths	(1½)
Precast	(✓)	1250	( )	250'	( )	Dishwasher	(no)
		1500	( )	Other 300'		Garbage Grdr.	(no)
		Other				Other Washing machine	

NOTIFY HEALTH DEPARTMENT AT LEAST EIGHT HOURS BEFORE TANK IS TO BE INSPECTED.

Final Inspection 1-17-1973 Approved (✓) Disapprcved ( )

Remarks approved Septic Tank System For Farmers Home Loan community water System

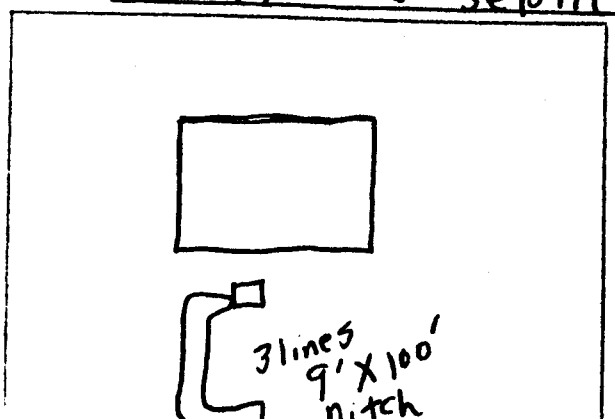

Sketch of Installation

J. C. Moore
Sanitarian