IREDELL COUNTY HEALTH DEPARTMENT

Statesville Phone TR 3-7271 Mooresville Phone No. 664-5281

PERMIT TO INSTALL SEPTIC TANK

Permit No. 2 Permit Date 1-3- 1973

Owner Hope Bros. Address Statesville

Installed By " Address "


Location of Property N.C. 115 South to Curtis Lake Rd off to left at Freemont Park. Lot no. 4

Tank		Capacity		Length of Lines		Fixtures	
Block	( )	1000	(✓)	225'	( )	No. of Baths	( )
Precast	(✓)	1250	( )	250'	( )	Dishwasher	( )
		1500	( )	Other 300'		Garbage Grdr.	( )
		Other				Other	

NOTIFY HEALTH DEPARTMENT AT LEAST EIGHT HOURS BEFORE TANK IS TO BE INSPECTED.

Final Inspection 1-3- 1972 Approved (✓) Disapprcved ( )

Remarks approved for Farmers Home Admn. ~~Loan~~ Central Water System

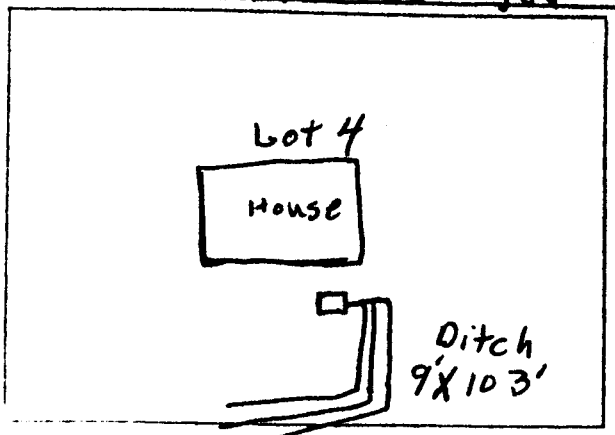

Sketch of Installation

J. C. Moore
Sanitarian