IREDELL COUNTY HEALTH DEPARTMENT

Statesville Phone TR 3-7271 Mooresville Phone No. 664-5281

PERMIT TO INSTALL SEPTIC TANK

Permit No. 132 Permit Date 6-18-1973

Owner Hope Brothers Address Statesville

Installed By " Address "


Location of Property 115 South TL on 1136 ½ mi on left Freemont Park Lot 5

Tank		Capacity		Length of Lines		Fixtures	
Block	( )	1000	(✓)	225'	( )	No. of Baths	(2)
Precast	(✓)	1250	( )	250'	( )	Dishwasher	(yes)
		1500	( )	Other 200'		Garbage Grdr.	(no)
		Other				Other washing machine	

NOTIFY HEALTH DEPARTMENT AT LEAST EIGHT HOURS BEFORE TANK IS TO BE INSPECTED.

Final Inspection 6-18-1973 Approved (✓) Disapproved ( )

Remarks Community water System

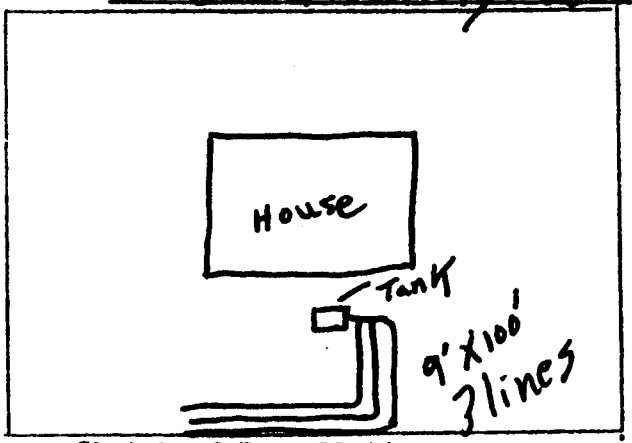

Sketch of Installation

J. C. Moore

Sanitarian