IREDELL COUNTY HEALTH DEPARTMENT

STATESVILLE 704-878-5305 MOORESVILLE 704-664-5281

IMPROVEMENT PERMIT / AUTHORIZATION TO CONSTRUCT / OPERATION PERMIT / EXISTING SYSTEM INSPECTION

PERMIT # 1627754 PIN # 4655274026 DATE 11-30-2010

OWNER or APPLICANT Neil Duprey PHONE: Business Home: 704 237-4368

OWNER or APPLICANT ADDRESS 196 Faith Rd Mooresville, NC. 28115

LOCATION / DIRECTIONS Hwy 115 S. to Faith Rd on Rt. after Ryan Acres ent. (Ryan Ln) #196

SUBDIVISION Ryan Acres BLOCK / SECTION LOT # 4 LOT AREA DESIGN FLOW 360gpd L.T.A.R.

EXIST

Septic Tank 1000 Gallons: STB Date

Pump Tank Gallons: PT Date

Pump Make Model Serial #

Nitrification Field No Fields 2 No Lines 9 Linear Feet 350 + 240

Trench Width 36" Max. Trench Bottom Depth N/A Gravel Depth 12" GRAVITY PRESSURE

☐ New System ☐ Repair ☐ Expansion System Type I II III IV V VI

System Description: Exist. Gravity Conventional

Repair System Description: Same

Maintenance Agreement Required ☐ YES ☐ NO

☒ Residence No. Bedrooms 3

☐ Business No. Persons

☐ Other No. Employees

☐ Slab ☐ Crawl Space


☐ Basement w/plumbing ☐ Basement w/o plumbing

Water Supply: ☒ Private ☐ Public ☐ Community


Comments / Conditions: Existing Septic appears to be functioning okay. If any wet areas in Drainfield then distribution needs to be changed.

Comments / Conditions: ☒ Must keep proposed structure at least 5ft from Septic System

INITIAL SITE SKETCH

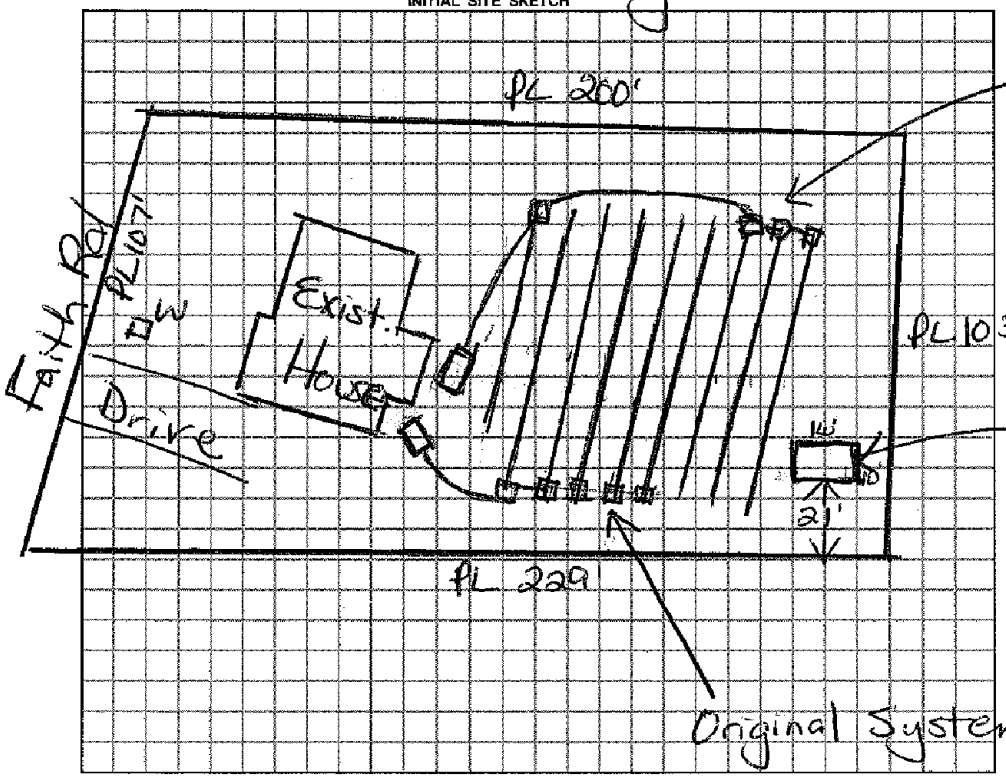

AS BUILT SKETCH

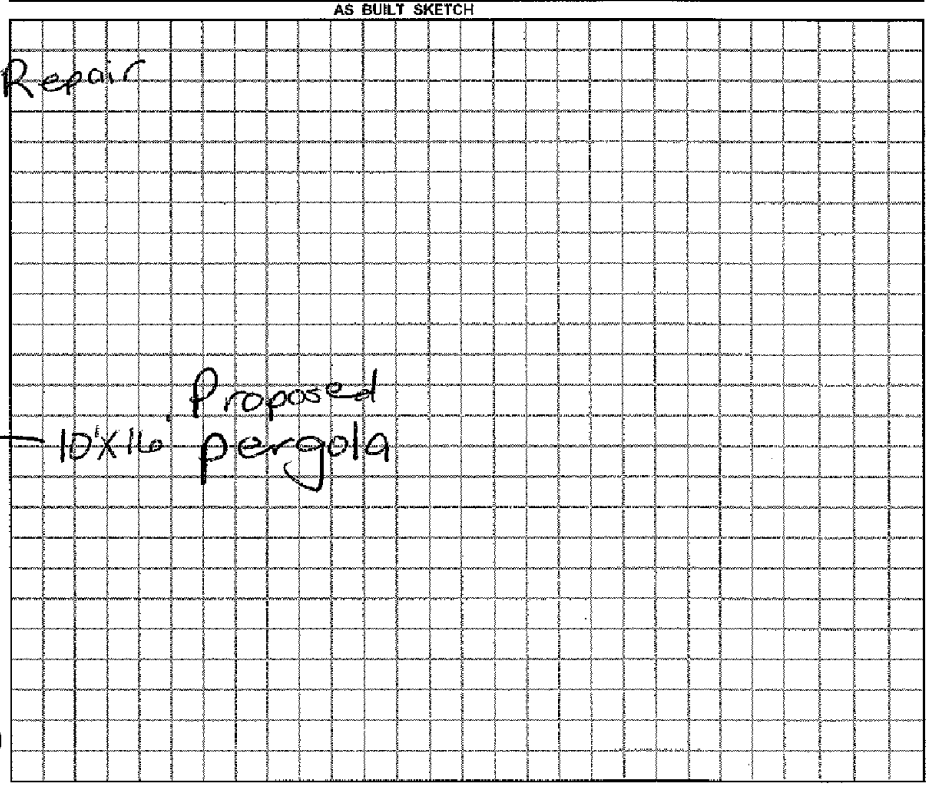

Permit can be suspended or revoked if any false information is supplied toward securing the permit / any unauthorized changes are made to the site / any unauthorized changes are made in the installation of the system.

☐ *IMPROVEMENT PERMIT w / plat valid without expiration.* ☐ *IMPROVEMENT PERMIT w / site plan valid for 60 mos.* ☐ *AUTHORIZATION TO CONSTRUCT valid for period equal to IMPROVEMENT PERMIT-not to exceed 60 mo.*

Owner / Applicant Signature: Neil C. Duprey Date 12/1/2010

Improvement Permit by: Maine Hill Odom RS Date 11/30/10

Authorization to Construct by: Date

Installed by:

Operation Permit by: Date:

Existing System Inspected by: Maine Hill Odom RS Date: 11/30/2010

YOU SHOULD CONTACT A LOCATOR SERVICE PRIOR TO ANY EXCAVATION.

WHITE COPY Environmental Health YELLOW COPY (Final) Owner / Applicant PINK COPY (Initial) Owner / Applicant