IREDELL COUNTY HEALTH DEPARTMENT

Statesville Phone TR 3-7271 Mooresville Phone No. 664-5281

PERMIT TO INSTALL SEPTIC TANK

Permit No. 139 Permit Date 6-21 1973

Owner Hope Bro Address Statesville N.C.

Installed By " " Address "


Location of Property 115-S. To Mt. Mourne T.L. on Rd #1136. Go about ½ Mile T.L. into Fremont Park House on R. Lot #7

| Tank | | Capacity | | Length of Lines | | Fixtures | |
|---|---|---|---|---|---|---|---|
| Block | ( ) | 1000 | (✓) | 225' | (✓) | No. of Baths | (1½) |
| Precast | (✓) | 1250 | ( ) | 250' | ( ) | Dishwasher | ( ) |
| | | 1500 | ( ) | Other | | Garbage Grdr. | ( ) |
| | | Other | | | | Other | |

NOTIFY HEALTH DEPARTMENT AT LEAST EIGHT HOURS BEFORE TANK IS TO BE INSPECTED.

Final Inspection 6-21 1973 Approved (✓) Disapproved ( )

Remarks Community Water Lines are Dep.

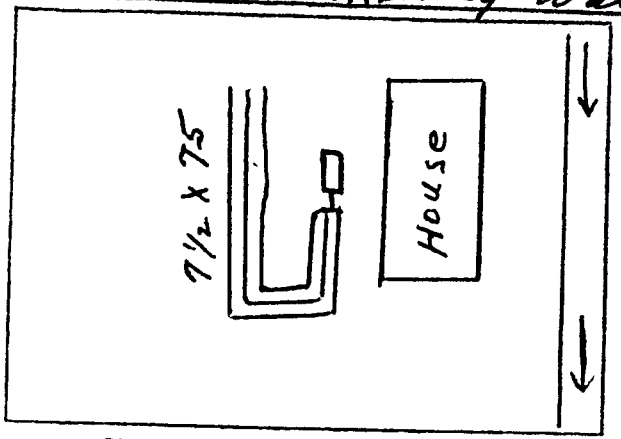


Sketch of Installation

E. G. Stevenson

Sanitarian