IREDELL COUNTY HEALTH DEPARTMENT

Statesville Phone TR 3-7271 Mooresville Phone No. 664-5281

PERMIT TO INSTALL SEPTIC TANK

Permit No. 208 Permit Date 8-22- 1973

Owner Hope Brothers Address Statesville

Installed By " Address "


Location of Property N.C. 115 South TL on 1136 ¼ mi on left Freemont Park Lot 8

Tank		Capacity		Length of Lines		Fixtures	
Block	( )	1000	(✓)	225'	(✓)	No. of Baths	(2)
Precast	(✓)	1250	( )	250'	( )	Dishwasher	( )
		1500	( )	Other		Garbage Grdr.	( )
		Other				Other Washing machine	

NOTIFY HEALTH DEPARTMENT AT LEAST EIGHT HOURS BEFORE TANK IS TO BE INSPECTED.

Final Inspection 8-22- 1973 Approved (✓) Disapproved ( )

Remarks Community Water System

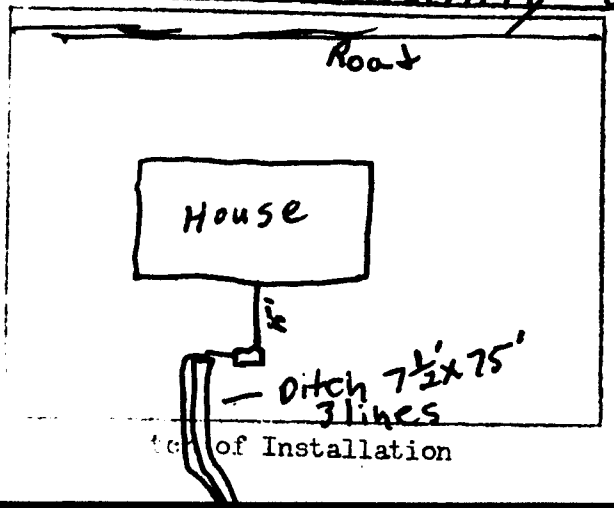

Plan of Installation

J. C. Moore
Sanitarian