4655285139

IREDELL COUNTY HEALTH DEPARTMENT

STATESVILLE 704-878-5305 MOORESVILLE 704-664-5281

IMPROVEMENT PERMIT / CERTIFICATE OF COMPLETION / OPERATION PERMIT / EXISTING SYSTEM INSPECTION

PROPERTY DESCRIPTION NO. Repair DATE 2/28/95 TAX MAP NO. Repair Watershed: ☐ Yes ☒ No

OWNER OR CONTRACTOR Robin Jones PHONE: Business _____ Home 892-7664

ADDRESS 239 Freemont Loop Mooresville, NC

LOCATION 1155 TL on Fourth Rd TL on 2nd Loop to 7th house on (R)

SUBDIVISION Freemont Lp. BLOCK / SECTION _____ LOT 9 LOT AREA Existing SITE CLASS. P DESIGN FLOW 360 L.T.A.R. _____

Septic Tank: Existing Gallons; STB _____ Date _____

Pump Tank: _____ Gallons; PT _____ Date _____

Pump Make: _____ Model _____ Serial No. 190

Nitrification Field: No Fields 1 Square Feet _____ Linear Feet ~~200~~ x

No Lines ~~5~~ 4 Trench Width 24" Max Trench Bottom Depth 36" Gravel Depth _____

☐ New System ☒ Repair System Type: I, II, III, IV, V, VI

System Description: Gravity - Prefab Panels

Repair System Description: _____

Maintenance Agreement Required: ☐ Yes ☐ No

☒ House/Mod. Home No. Bedrooms 3

☐ Mobile Home No. Bathrooms 2

☐ Business No. Employees _____

☐ Other _____


☐ Slab ☒ Crawl Space ☐ Basement w/plumbing ☐ Basement wo/plumbing

Water Supply:
☐ Individual
☐ Community
☐ Public


Comments: Hope Brothers - 73
Rework H2O line around drainfield 95 16" PPAS
drainlines in direction shown.

Comments:
Hot line elevation called PVC to house
from meter

INITIAL SITE SKETCH

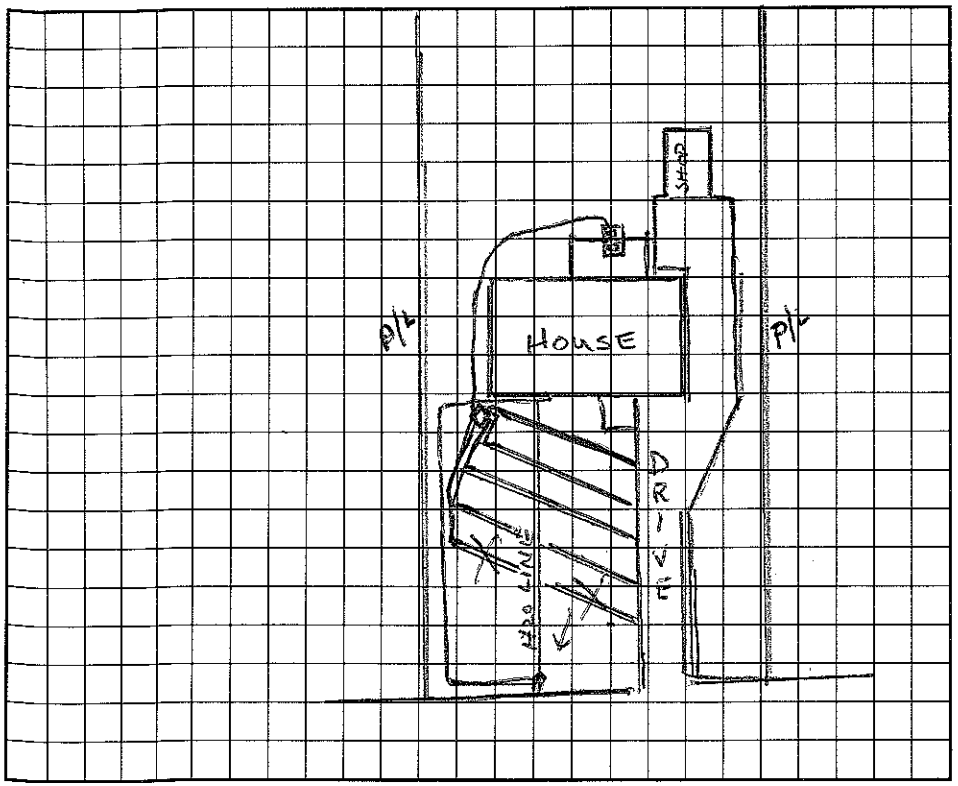

AS BUILT SKETCH

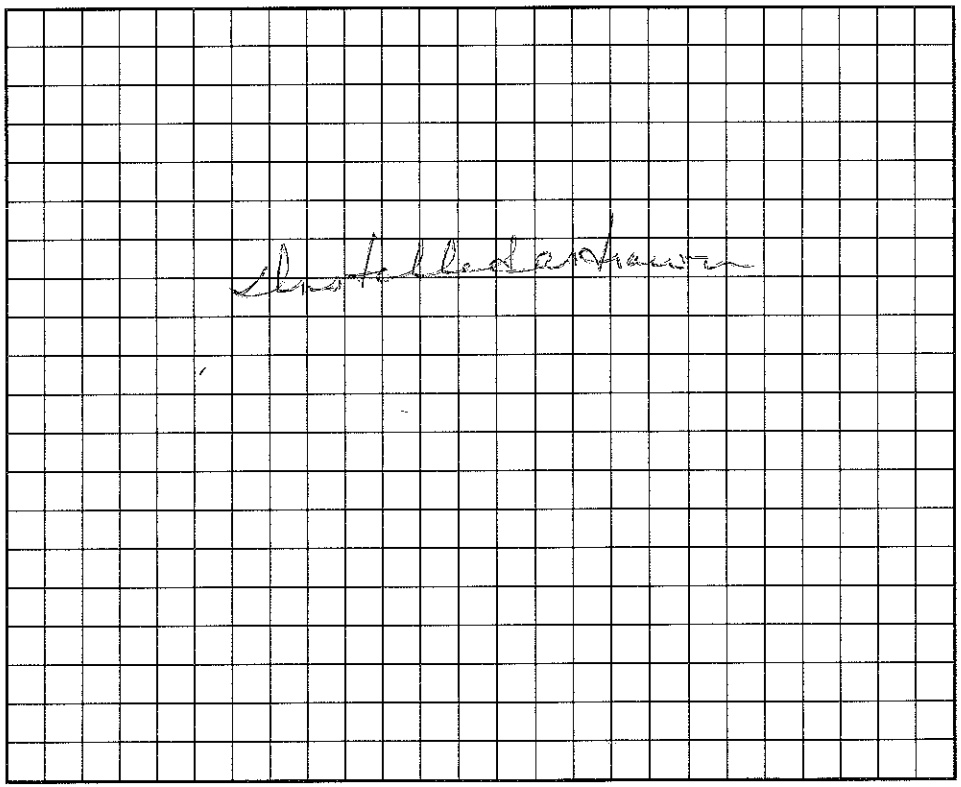

I understand that this permit can be suspended or revoked if any false information is supplied toward securing the permit/any unauthorized changes are made to the site/any unauthorized changes are made in the installation of the system. Improvement Permit is valid for 60 months from date of issuance.

Signed: _____

Improvement Permit by: Wesley Sparks RS. date 2/28/95

Existing System Inspection by: _____ date _____

Installed by: Tim Simmons

Certificate of Completion by: Wesley Sparks RS. date 4/20/95

Operation Permit by: _____ date _____

HEALTH DEPT. COPY: WHITE INSPECTION COPY (FINAL): GREEN OWNER COPY (FINAL): YELLOW INSPECTION COPY (INITIAL): PINK OWNER COPY (INITIAL): GOLD