Repair

IREDELL COUNTY HEALTH DEPARTMENT

STATESVILLE 704-878-5305 MOORESVILLE 704-664-5281

2130

IMPROVEMENT PERMIT / AUTHORIZATION TO CONSTRUCT / OPERATION PERMIT / EXISTING SYSTEM INSPECTION

PERMIT# Repair PIN# PIN# 4655-28-7755 DATE 2-10-03

OWNER OR CONTRACTOR Jimmy Grindstaff PHONE: Business 892-6799 Home

ADDRESS 211 Freemont Cp.

LOCATION Hwy 115 South TL Faith Rd TL 2nd Freemont Lp on right

SUBDIVISION Freemont Pk BLOCK / SECTION 2 LOT 101 LOT AREA SITE CLASS. PS DESIGN FLOW 360gpd L.T.A.R.

EXIST

Septic Tank: 1000 Gallons; STB Date

Pump Tank: Gallons; PT Date

Pump Make: Model Serial No.

Nitrification Field: No Fields 1 Square Feet 540 Linear Feet 180

No Lines 3@60' Trench Width 36" Max Trench Bottom Depth 36"+ Gravel Depth N/A

☐ New System ☒ Repair System Type: I, II, III, IV, V, VI

System Description: Gravity - Convent

Repair System Description: Gravity - 25% Reduct.

Maintenance Agreement Required: ☐ Yes ☒ No

☒ House/Mod. Home ☐ Mobile Home ☐ Business ☐ Other

No. Bedrooms 3 No. Bathrooms 2 No. Employees


☐ Slab ☐ Crawl Space ☐ Basement w/plumbing ☐ Basement wo/plumbing

Water Supply: ☐ Individual ☒ Public ☒ Community

Comments:/Conditions: Install 3 lines @ 60' each - Plastic Chamber or EZ Flow. Keep lines as far uphill as possible. Soil becomes unsuitable below repair lines.

Comments:/Conditions: Keep new line at least 9' from existing line. Install Bull run valve

★ Not to Scale INITIAL SITE SKETCH

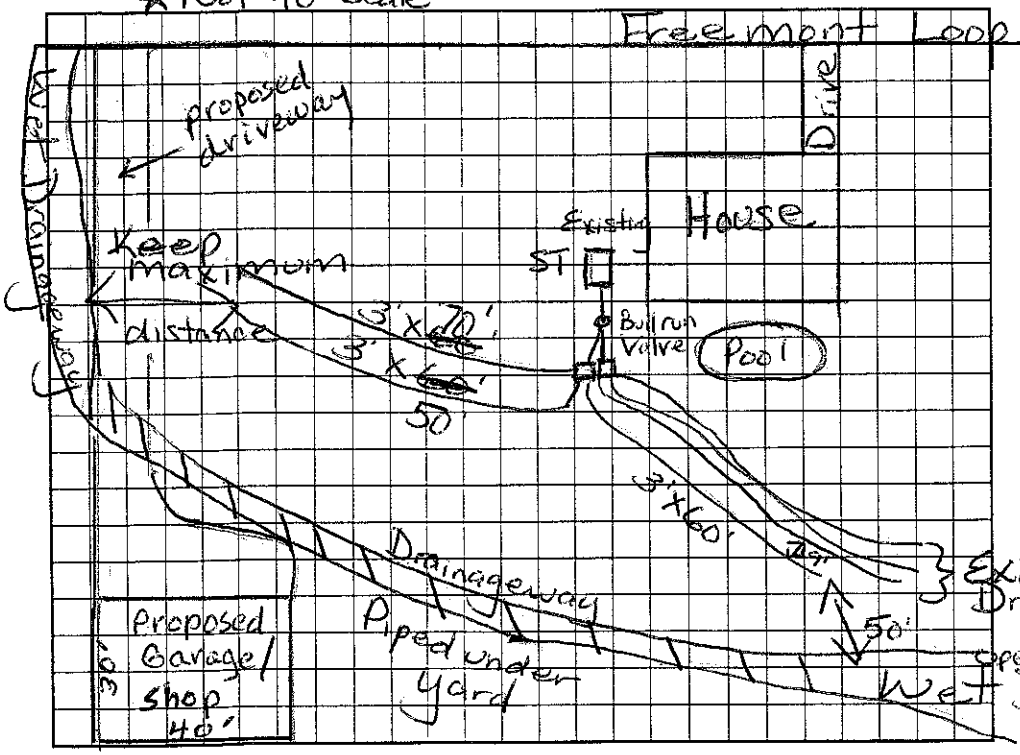

AS BUILT SKETCH

2/26/03 Checked 2 lines to right of house EZ Flow lines installed

The location of the proposed Garage / shop addition does not appear to impact the existing septic system.

**NOTE: Driveway shall not be over drainfield.

No plumbing inside building

Cindy Melville REHS

Date: 12-13-11

ICHD-Environmental Health Division

Permit can be suspended or revoked if any false information is supplied toward securing the permit/any unauthorized changes are made to the site/any unauthorized changes are made in the installation of the system. Improvement Permit with plat valid without expiration. Improvement Permit with site plan valid for sixty months. Authorization to Construct is valid for a period equal to that of Improvement Permit – not to exceed sixty months.

Signed X Deanna B. Grindstaff date 02/10/03

Improvement Permit by: Maria H. Tolson R.S. date 2/10/03

Authorization to Construct by: Maria H. Tolson RS date 2/10/03

Repair

Installed by: F J Eaton R.S.

Operation Permit by: Maria H. Tolson date 2/25/03

Existing System Inspection by: date

HEALTH DEPT. COPY: WHITE OWNER COPY (FINAL): YELLOW OWNER COPY (INITIAL): PINK