IREDELL COUNTY HEALTH DEPARTMENT

STATESVILLE 704-878-5305 (1) MOORESVILLE 704-664-5281

1:30-2:00

IMPROVEMENT PERMIT / AUTHORIZATION TO CONSTRUCT / OPERATION PERMIT / EXISTING SYSTEM INSPECTION

PERMIT# 10427 PIN# ~~4655.30.2527.9~~ 4655-50-2235 ~~ef~~ DATE 6-16-04

OWNER OR CONTRACTOR Amy Wheat PHONE: Business 365-2014 ~~4234~~ Home

ADDRESS 108 Peninsula Place Lane, Mooresville, NC 28117

LOCATION Hwy 115 S to Midway Lake to Monarch Ln 2nd lot on right

SUBDIVISION Davidson Creek BLOCK / SECTION LOT 39 LOT AREA 1.07 Acre SITE CLASS. PS DESIGN FLOW 360gpd L.T.A.R. ~25

Septic Tank: 1000 Gallons; STB 1007 Date 7-11-04
Pump Tank: Gallons; PT Date
Pump Make: Model Serial No.
Nitrification Field: No Fields 1 Square Feet 720' Linear Feet 240'
No Lines Log 40' Trench Width 24"-36" Max Trench Bottom Depth 36" Gravel Depth N/A

☒ New System ☐ Repair System Type: I, II, (III), IV, V, VI
System Description: Gravity - Panel Block
Repair System Description: Rock/Gravity Panel Alt
Maintenance Agreement Required: ☐ Yes ☒ No


☒ House/Mod. Home No. Bedrooms 3
☐ Mobile Home No. Bathrooms 2½
☐ Business No. Employees
☐ Other
☐ Slab ☒ Crawl Space ☐ Basement w/plumbing ☐ Basement wo/plumbing

Water Supply: ☒ Individual ☐ Public ☐ Community

Comments:/Conditions: Keep Septic System at least 10' from PL
Okay to use "Drop boxes" instead of D-box
Scale 1:50

Comments:/Conditions: Panel Block = 50% Reduction in Drain Field Area. Used "Drop boxes" Took 10' off last line to maintain 100' from well ~~Well~~ installed further from Street than on permit

INITIAL SITE SKETCH

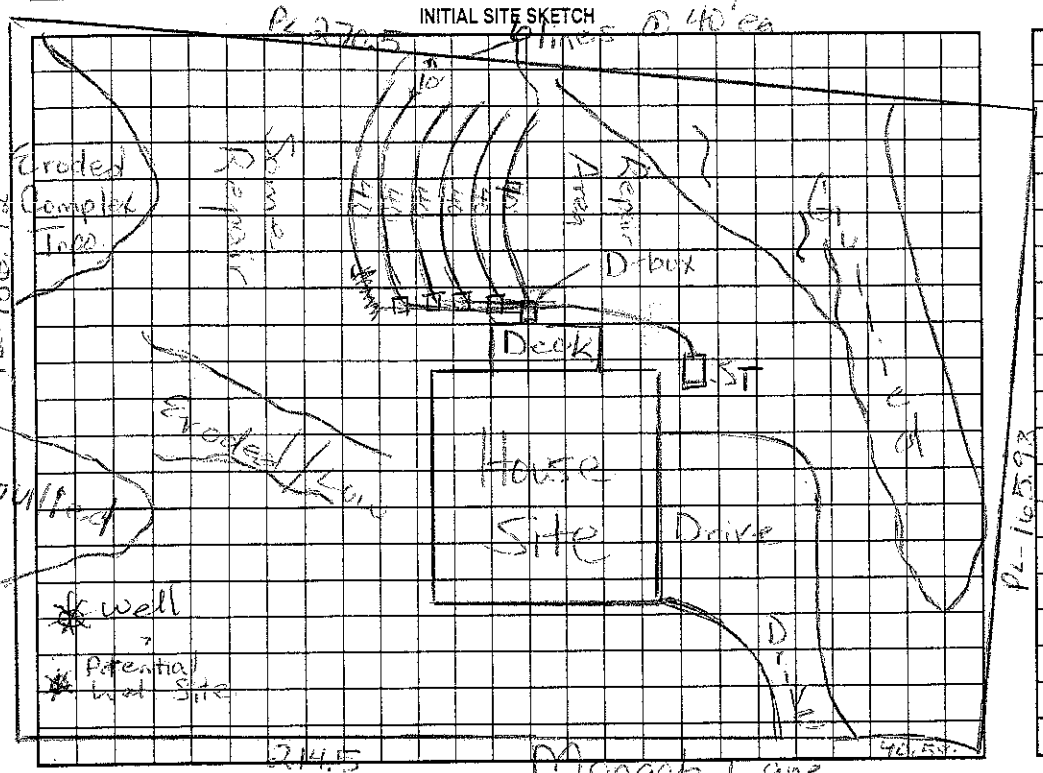

AS BUILT SKETCH

Permit can be suspended or revoked if any false information is supplied toward securing the permit/any unauthorized changes are made to the site/any unauthorized changes are made in the installation of the system. Improvement Permit with plat valid without expiration. Improvement Permit with site plan valid for sixty months. Authorization to Construct is valid for a period equal to that of Improvement Permit – not to exceed sixty months.

Signed: A. Wheat date 6-28-04

Improvement Permit by: Maria H. Dotson RS date 6/16/04

Authorization to Construct by: Maria H. Dotson RS date 6/16/04

Installed by: Wayne Glentz RS

Operation Permit by: Maria H. Dotson RS date 10/7/04

Existing System Inspection by: date

HEALTH DEPT. COPY: WHITE OWNER COPY (FINAL): YELLOW OWNER COPY (INITIAL): PINK