IREDELL COUNTY HEALTH DEPARTMENT

STATESVILLE 704-878-5305 MOORESVILLE 704-664-5281

IMPROVEMENT PERMIT / AUTHORIZATION TO CONSTRUCT / OPERATION PERMIT / EXISTING SYSTEM INSPECTION

PERMIT# 071580 PIN# 4655325837 DATE 3/9/98

OWNER OR CONTRACTOR Aztec Holdings Inc. (Joe Hall) PHONE: Business _____ Home _____

ADDRESS PO Box 669324 Charlotte NC 4655-32-5837

LOCATION Hwy 115 S. to Eastpoint continue on Eastpoint TR Panther Hill on Rt. Near End

SUBDIVISION Oakridge BLOCK / SECTION _____ LOT 8 LOT AREA 20,000 Ft² SITE CLASS. Existing DESIGN FLOW _____ L.T.A.R. Existing

Septic Tank: 1000 Gallons; STB 797 Date 1/13/98
Pump Tank: _____ Gallons; PT _____ Date _____
Pump Make: _____ Model _____ Serial No. _____
Nitrification Field: No Fields _____ Square Feet Existing Linear Feet _____
No Lines _____ Trench Width _____ Max Trench Bottom Depth _____ Gravel Depth _____

☐ New System ☐ Repair System Type: I, II, III, IV, V, VI
System Description: Existing
Repair System Description: _____
Maintenance Agreement Required: ☐ Yes ☐ No

☒ House/Mod. Home No. Bedrooms 3
☒ Mobile Home No. Bathrooms 2
☐ Business No. Employees _____
☐ Other _____


☐ Slab ☒ Crawl Space ☐ Basement w/plumbing ☐ Basement wo/plumbing

Water Supply: ☒ Individual ☐ Public ☐ Community


Comments:/Conditions: Abandon Existing Septic Tank, Install New Septic Tank 5' From M.H. & at least 50' from Existing Wells & 10' From PL Okay to use Existing Drainfield.

Comments:/Conditions: Replacing Mobile Home.

INITIAL SITE SKETCH Scale 1:50

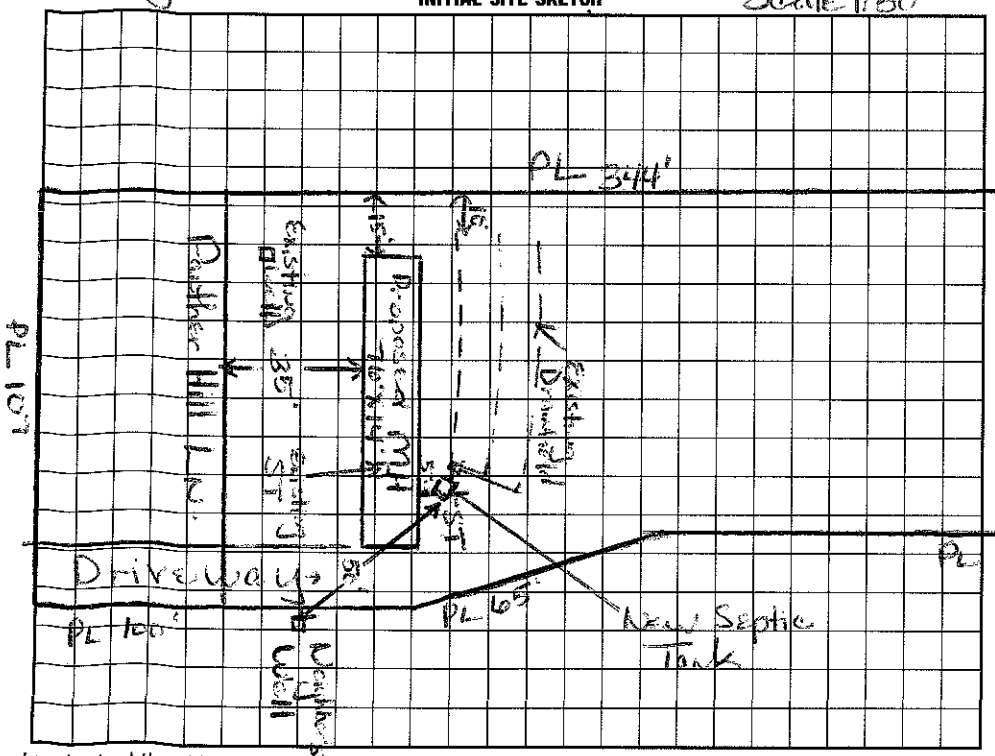

AS BUILT SKETCH

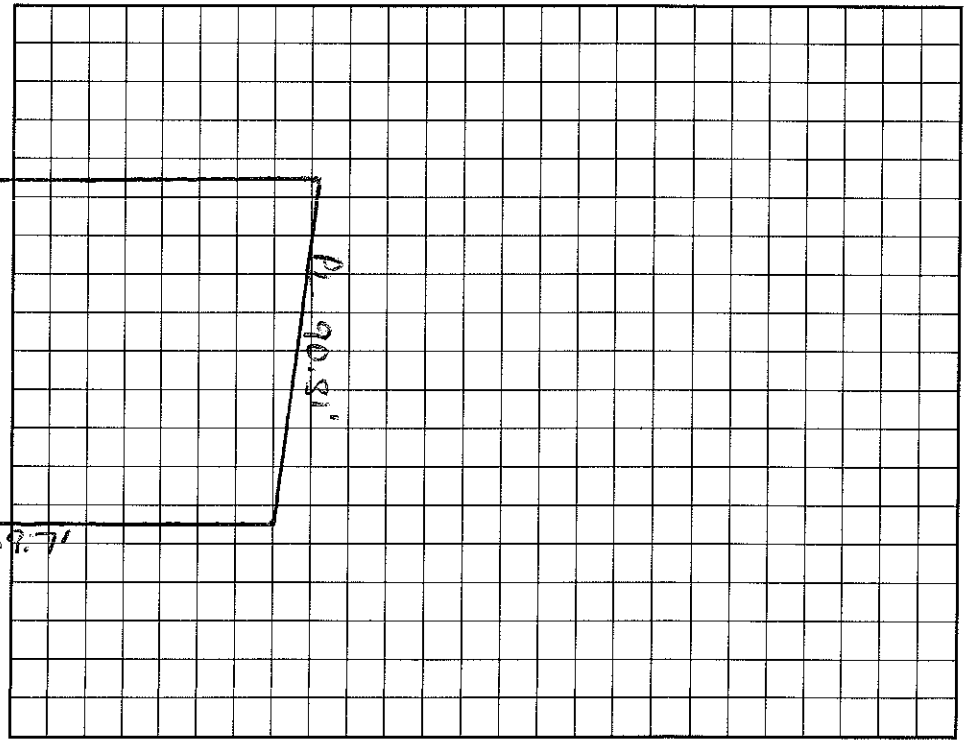

I understand that this permit can be suspended or revoked if any false information is supplied toward securing the permit/any unauthorized changes are made to the site/any unauthorized changes are made in the installation of the system. Improvement Permit with plat valid without expiration. Improvement Permit with site plan valid for sixty months. Authorization to Construct is valid for a period equal to that of Improvement Permit – not to exceed sixty months.

Signed: J Erwin date 3/26/98
Improvement Permit by: Maria H. Hutton date 3/9/98
Authorization to Construct by: Maria H. Hutton date 3/9/98

Installed by: FJ Erwin
Operation Permit by: Wesley Stephens RS. date 4/2/98
Existing System Inspection by: Wesley Stephens RS. date 4/2/98

HEALTH DEPT. COPY: WHITE INSPECTION COPY (FINAL): GREEN OWNER COPY (FINAL): YELLOW INSPECTION COPY (INITIAL): PINK OWNER COPY (INITIAL): GOLD