IREDELL COUNTY HEALTH DEPARTMENT

STATESVILLE 704-878-5305 MOORESVILLE 704-664-5281

IMPROVEMENT PERMIT / CERTIFICATE OF COMPLETION / OPERATION PERMIT / EXISTING SYSTEM INSPECTION

PROPERTY DESCRIPTION NO. 16830 DATE 8/19/93 TAX MAP NO. 2A-4-A-4

OWNER OR CONTRACTOR GILBERT ETENNENT PHONE: Business Home 892-4253

ADDRESS R+11 BOX 1293 MOORESVILLE 4655-33-2355

LOCATION OAKRIDGE LN. / 1853 TL ON EAST PORT LN, TR TO OAKRIDGE TR TO 2ND LOT ON L

SUBDIVISION OAK RIDGE BLOCK / SECTION LOT 4 LOT AREA ~20,000 FT² SITE CLASS. P L.T.A.R. .3-.35

Water Supply: ☐ Individual ☑ Community ☐ Public ATT TRAILERS TO (L)

Septic Tank: 1000 Gallons; STB 358 Date 8-20-93

Pump Tank: Gallons; PT Date

Nitrification Field: No Fields 1 Square Feet 1026 Linear Feet 342

No Lines 4 Trench Width 36" Trench Depth 32-34" Gravel Depth 12"

☑ New System ☐ Repair System Type: I, (II), III, IV, V, VI

System Description: CONV - DROP BOX

Repair System Description: CONV - DROP BOX

Maintenance Agreement Required: ☐ Yes ☐ No

☐ House/Mod. Home ☑ Mobile Home ☐ Business ☐ Other

No. Bedrooms 3 No. Bathrooms 2 No. Employees

☐ Slab ☑ Crawl Space ☐ Basement w/plumbing ☐ Basement wo/plumbing

Garbage Disposal: ☐ Yes ☑ No


Auto. Dishwasher: ☑ Yes ☐ No

Auto. Washing Machine: ☑ Yes ☐ No

Other

Comments TRENCH BOTTOM 32-34" / LINES ON SLOPE CONTOUR

INITIAL SITE SKETCH

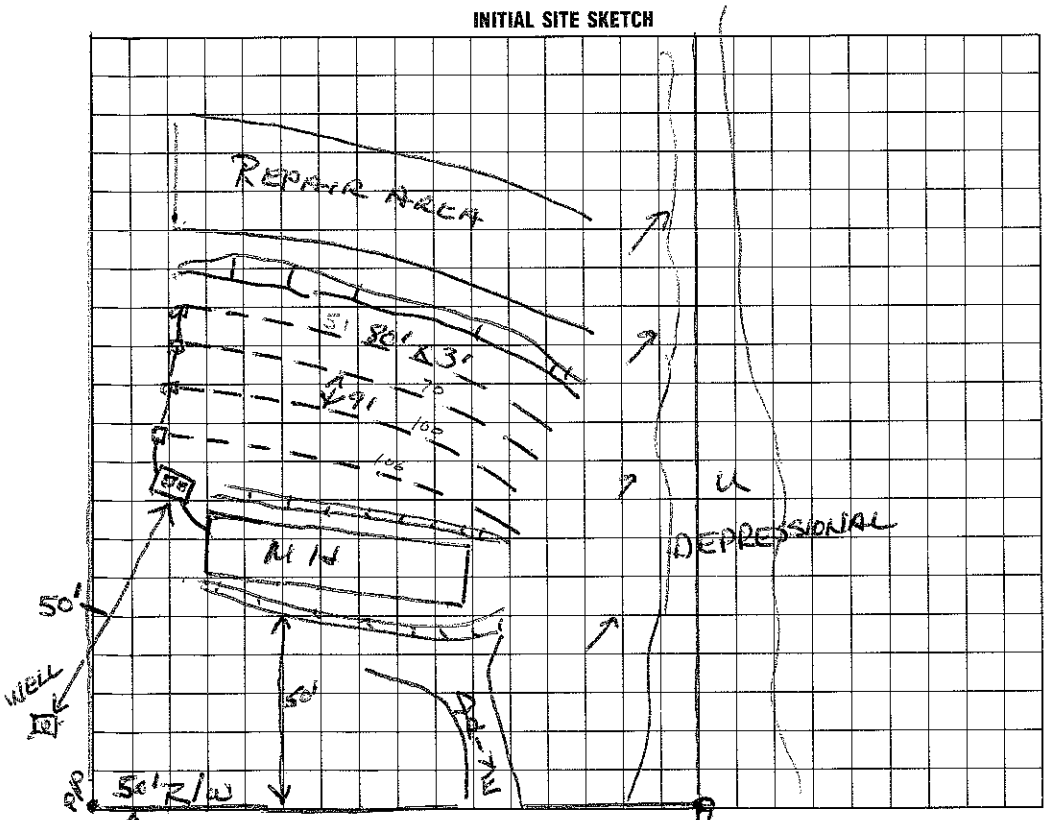

AS BUILT SKETCH

I understand that this permit can be suspended or revoked if any false information is supplied toward securing the permit/any unauthorized changes are made to the site/any unauthorized changes are made in the installation of the system. Improvement Permit is valid for 60 months from date of issuance.

Signed: Gilbert Eugene Tennent

Improvement Permit by: Wesley Sparks RS. date 8/19/93

Existing System Inspection by: date

Installed by: Dean Tennent

Certificate of Completion by: Wesley Sparks RS date 10/1/93

Operation Permit by: date

HEALTH DEPT. COPY: WHITE INSPECTION COPY (FINAL): GREEN OWNER COPY (FINAL): YELLOW INSPECTION COPY (INITIAL): PINK OWNER COPY (INITIAL): GOLD