IREDELL COUNTY HEALTH DEPARTMENT

STATESVILLE 704-878-5305 MOORESVILLE 704-664-5281

IMPROVEMENT PERMIT / AUTHORIZATION TO CONSTRUCT / OPERATION PERMIT / EXISTING SYSTEM INSPECTION

PERMIT# 065852 PIN# 4655341918 DATE Sept. 24, '99

OWNER OR CONTRACTOR Blake Lawing PHONE: Business 399-4710, 399-4781 Home 896-8896

ADDRESS 2017 Mecklenburg Hwy Mooresville

LOCATION 115S, TL Faith Road TR Live Oak Lane at end on left 165 Live Oak Rd

SUBDIVISION L.G. Caldwell Estates BLOCK / SECTION 2nd Land LOT 9 LOT AREA 4.97Ac SITE CLASS. PS DESIGN FLOW 240gpd L.T.A.R. .5

Septic Tank: 1000 Gallons; STB 794 Date 9-4-01

Pump Tank: 1000 Gallons; PT 283 Date 10-7-01

Pump Make: Barnes Model 51255A Serial No. L830990-10

Nitrification Field: No Fields 1 Square Feet ≈500 Linear Feet 200

No Lines 4 @ 50' Trench Width 18"± Max Trench Bottom Depth 24" Gravel Depth NA

☑ New System ☐ Repair System Type: I, II, III, IV, V, VI

System Description: pm - 10" Lg Diameter Pipe

Repair System Description: BORONA MONA - Drip Irrigation

Maintenance Agreement Required: ☐ Yes ☑ No initially

☑ House/Mod. Home ☐ Mobile Home ☐ Business ☐ Other

No. Bedrooms 2 No. Bathrooms 2½ No. Employees

Water Supply: ☑ Individual ☐ Public ☐ Community


☑ Slab ☑ Crawl Space ☐ Basement w/plumbing ☐ Basement wo/plumbing

Comments/Conditions: Space Laterals no more than 8' on center.


Comments/Conditions: (partial)
11/15 Filter not installed yet
Checked tanks & lines 11/15/2001. MZ
Caulk around wires into elect box & out of tank 2

1" ≈ 100'

INITIAL SITE SKETCH

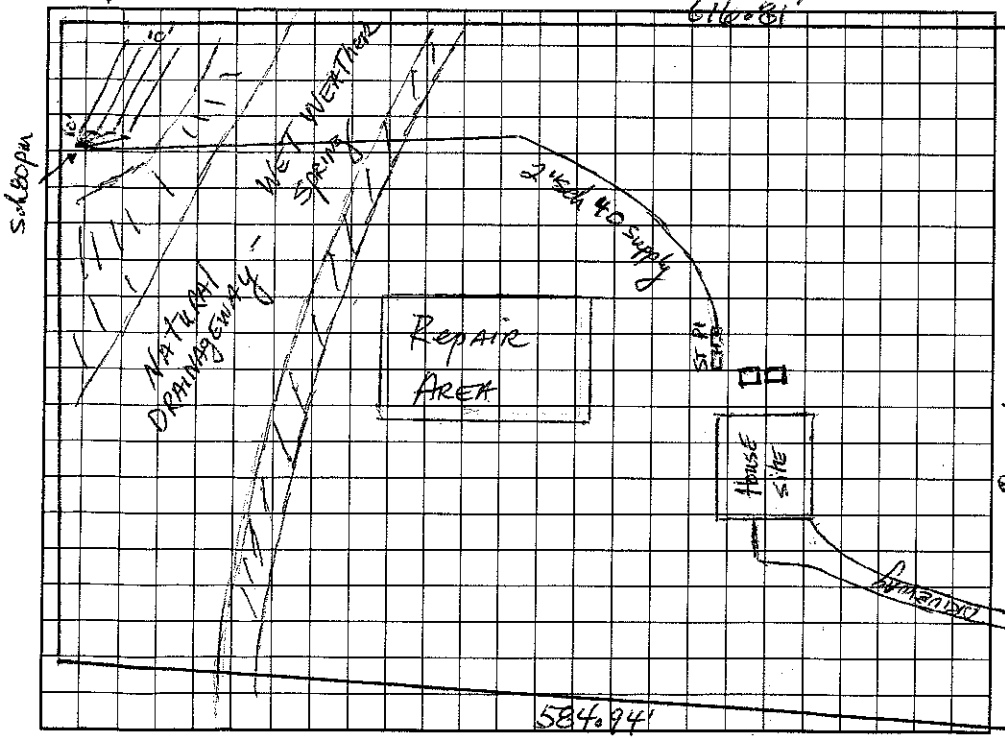

AS BUILT SKETCH

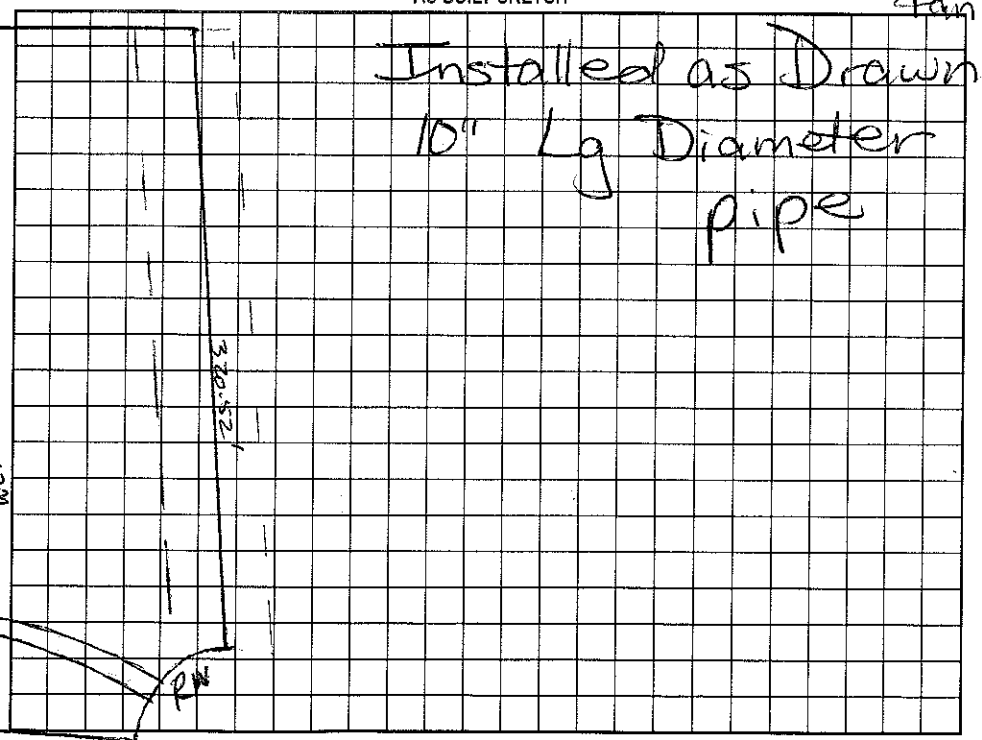

Permit can be suspended or revoked if any false information is supplied toward securing the permit/any unauthorized changes are made to the site/any unauthorized changes are made in the installation of the system. Improvement Permit with plat valid without expiration. Improvement Permit with site plan valid for sixty months. Authorization to Construct is valid for a period equal to that of Improvement Permit – not to exceed sixty months.

Signed: Blake Lawing date 9-27-99

Improvement Permit by: David Hoffman, RS date 9-24-99

Authorization to Construct by: David Hoffman, RS date 9-24-99

Installed by: Blake Lawing

Operation Permit by: Maria H. Hutchinson, RS date 1/16/2002

Existing System Inspection by: date

HEALTH DEPT. COPY: WHITE OWNER COPY (FINAL): YELLOW OWNER COPY (INITIAL): PINK