IREDELL COUNTY HEALTH DEPARTMENT

STATESVILLE 704-878-5305 MOORESVILLE 704-664-5281

IMPROVEMENT PERMIT / AUTHORIZATION TO CONSTRUCT / OPERATION PERMIT / EXISTING SYSTEM INSPECTIO

1218

PERMIT# 127900 PIN# ~~4655356157~~ 4655-34-5906 George DATE 8-16-05

OWNER OR CONTRACTOR Moser Brothers Inc. PHONE: Business 634-9703 Home 663-4020

ADDRESS 119 Barber Loop Mooresville, NC 28117

LOCATION Highway 115 South TL Faith TR Midway Lake Rd TR Tradition Ln at end on right

SUBDIVISION The Homeplace BLOCK / SECTION ____ LOT 4 LOT AREA 2.3 Acres SITE CLASS. PS DESIGN FLOW 480gpd L.T.A.R. .3

Septic Tank: 1000 Gallons; STB 1007 Date 2-3-06
Pump Tank: ____ Gallons; PT ____ Date ____
Pump Make: ____ Model ____ Serial No. ____
Nitrification Field: No Fields 1 Square Feet 1200' Linear Feet 400'
No Lines 4@100' Trench Width 36" Max Trench Bottom Depth 36" Gravel Depth N/A

[X] New System [ ] Repair System Type: I, II, III, IV, V, VI
System Description: Gravity - 25% Reduction
Repair System Description: Same
Maintenance Agreement Required: [ ] Yes [X] No

[X] House/Mod. Home No. Bedrooms 4
[ ] Mobile Home No. Bathrooms 4
[ ] Business No. Employees ____
[ ] Other ____

[ ] Slab [X] Crawl Space [ ] Basement w/plumbing [ ] Basement wo/plumbing


Water Supply: [X] Individual [ ] Public [ ] Community

Comments:/Conditions: Okay to use Distribution box or Drop boxes.


Comments:/Conditions: *Keep pool at least 15' from Septic System. Some low chroma Mottles found w/ 1/3 way thru trenches therefore interceptor drain installed to keep extra water out

Scale 1:100

INITIAL SITE SKETCH

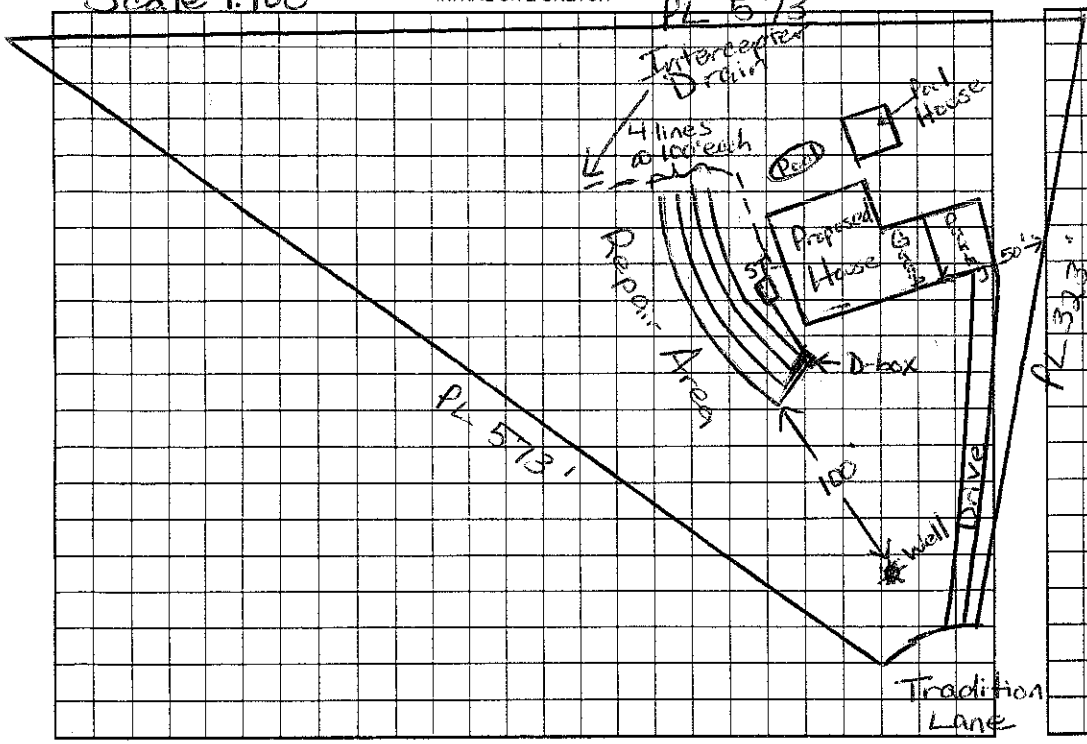

AS BUILT SKETCH

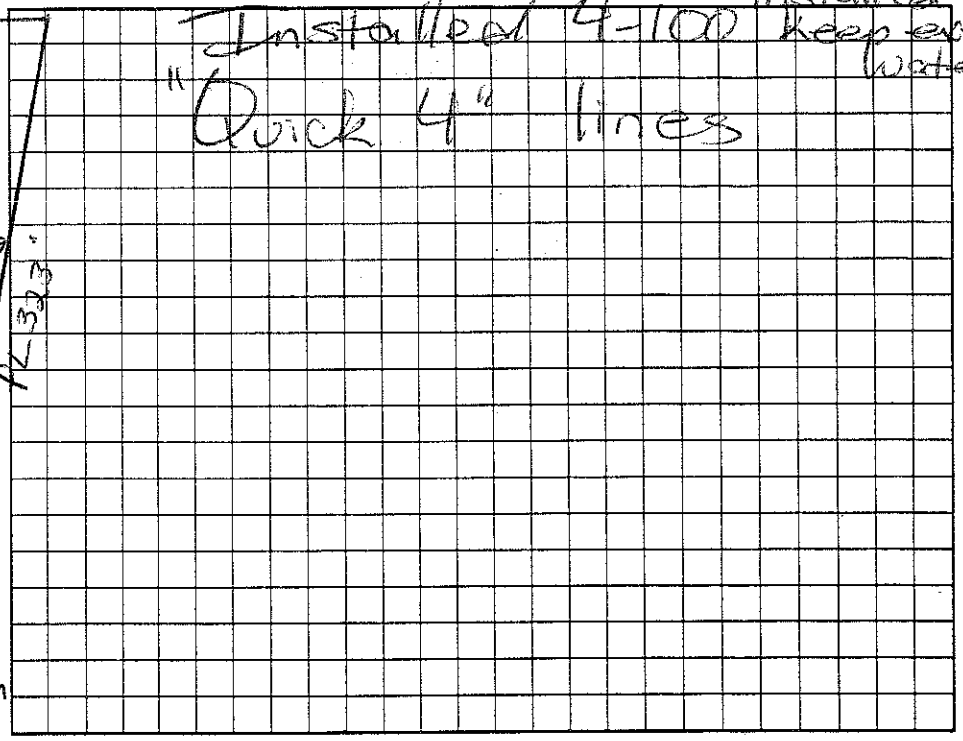

Permit can be suspended or revoked if any false information is supplied toward securing the permit/any unauthorized changes are made to the site/any unauthorized changes are made in the installation of the system. Improvement Permit with plat valid without expiration. Improvement Permit with site plan valid for sixty months. Authorization to Construct is valid for a period equal to that of Improvement Permit – not to exceed sixty months.

Signed: Alita J Moser date 8/16/05 Installed by: A & S Grading

Improvement Permit by: Maria H. Dotson RS date 8/16/05 Operation Permit by: Maria H. Dotson RS date 4/6/06

Authorization to Construct by: Maria H. Dotson RS date 8/16/05 Existing System Inspection by: ____ date ____

HEALTH DEPT. COPY: WHITE OWNER COPY (FINAL): YELLOW OWNER COPY (INITIAL): PINK