4655 34 9314

IREDELL COUNTY HEALTH DEPARTMENT

STATESVILLE 704-878-5305 MOORESVILLE 704-664-5281

IMPROVEMENT PERMIT / AUTHORIZATION TO CONSTRUCT / OPERATION PERMIT / EXISTING SYSTEM INSPECTION

PERMIT # 165623 PIN # 4655440289 DATE 5-6-2011

OWNER or APPLICANT Dan Schnars PHONE: Business Home:

OWNER or APPLICANT ADDRESS 10204 Haggers Rd Huntersville NC 28078

LOCATION / DIRECTIONS Hwy 115 South TL Eastport Ln Follow Eastport to end in Culdesac

SUBDIVISION Vanalen Acres BLOCK / SECTION LOT # 2 LOT AREA 1.576Ac. DESIGN FLOW 360 L.T.A.R.

Septic Tank 1000 Gallons: STB Date

Pump Tank Gallons: P T Date

Pump Make Model Serial #

Nitrification Field No Fields 1 No Lines 3 Linear Feet ~300ft

Trench Width 36" Max. Trench Bottom Depth Gravel Depth

☐ New System ☐ Repair ☐ Expansion System Type I II III IV V VI

System Description: Exist Gravity - Conventional

Repair System Description: Modified Convent.

Maintenance Agreement Required ☐ YES ☒ NO

☒ GRAVITY ☐ PRESSURE

☒ Residence No. Bedrooms 3

☐ Business No. Persons

☐ Other No. Employees

☐ Slab ☒ Crawl Space

☐ Basement w/plumbing ☐ Basement w/o plumbing

Water Supply: ☒ Private ☐ Public ☐ Community


Exist

Comments / Conditions: ☒ Must keep new home at least 5ft from Septic & 25ft from well. House Orientation may change

Out Bldg. 16'x20'

Comments / Conditions Existing Septic System "appears" to be functioning okay at time of inspection however Septic has been "out of use"

INITIAL SITE SKETCH

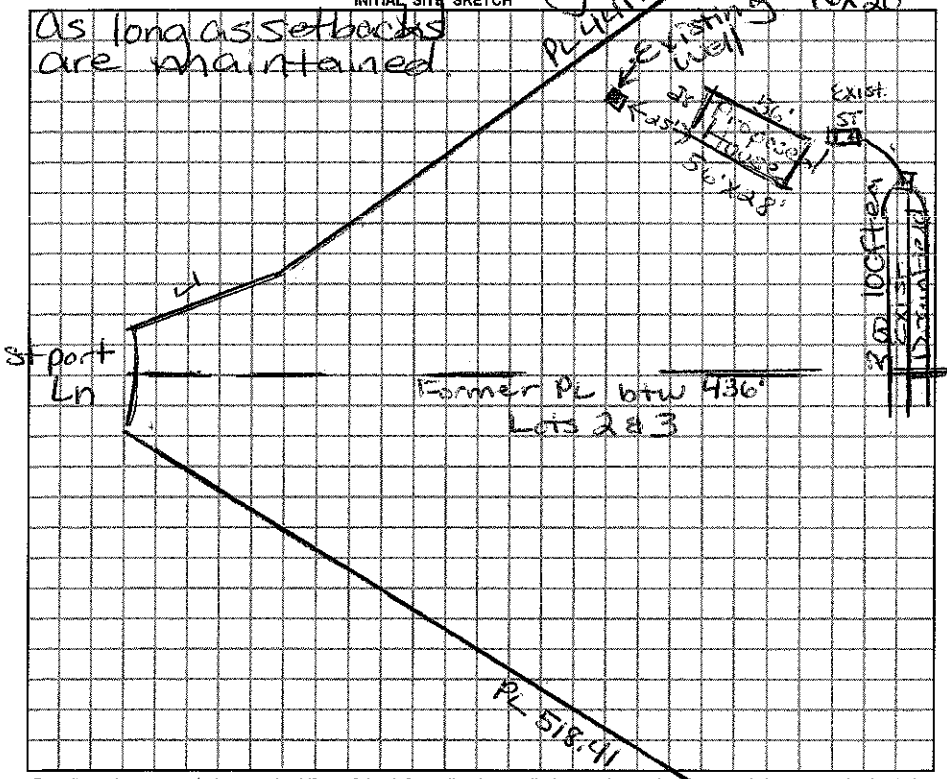

AS BUILT SKETCH

Note: Could not locate original permit - therefore line lengths & location may vary some from shown.

The proposed / existing Out Bldg (16'x20') addition does not appear to impact the existing septic system

**NOTE: Must keep 5ft from Septic & 25ft From well

Maria Colson REHS

Date: 7/18/2011

ICHD-Environmental Health Division

Permit can be suspended or revoked if any false information is supplied toward securing the permit / any unauthorized changes are made to the site / any unauthorized changes are made in the installation of the system.

☐ *IMPROVEMENT PERMIT w / plat valid without expiration.* ☐ *IMPROVEMENT PERMIT w / site plan valid for 60 mos.* ☐ *AUTHORIZATION TO CONSTRUCT valid for period equal to IMPROVEMENT PERMIT-not to exceed 60 mo.*

Owner / Applicant Signature: William T Schnars Date 5/9/11

Improvement Permit by: Date

Authorization to Construct by: Date

YOU SHOULD CONTACT A LOCATOR SERVICE PRIOR TO ANY EXCAVATION.

Installed by:

Operation Permit by: Date:

Existing System Inspected by: Maria Colson Date: REHS 5/6/11

WHITE COPY Environmental Health YELLOW COPY (Final) Owner / Applicant PINK COPY (Initial) Owner / Applicant