IREDELL COUNTY HEALTH DEPARTMENT

STATESVILLE 704-878-5305 130.00 Paid MOORESVILLE 704-664-5281

2-2670

IMPROVEMENT PERMIT / AUTHORIZATION TO CONSTRUCT / OPERATION PERMIT / EXISTING SYSTEM INSPECTION

PERMIT# 115775 PIN# 4655-35-8479 DATE 10/6/03

OWNER OR CONTRACTOR Moser Bros. Inc. PHONE: Business 704-634-9703 Home

ADDRESS 119 Barber Cp. Mooresville NC 28117

LOCATION 115 S, TL Faith, TR Midway LK, 1st Rt, attend on Rt

SUBDIVISION The Homeplace BLOCK / SECTION LOT 3 LOT AREA 3.05 Ac SITE CLASS. PS DESIGN FLOW 480 L.T.A.R. 0.35

Septic Tank: 1000 Gallons; STB 312 Date 11/10/03
Pump Tank: Gallons; PT Date
Pump Make: Model Serial No.
Nitrification Field: No Fields 1 Square Feet 1029 Linear Feet 343
No Lines 3 or 4 Trench Width 36" Max Trench Bottom Depth 36" Gravel Depth —

☒ New System ☐ Repair System Type: I, II, (III), IV, V, VI
System Description: Gravity 250 Reduct
Repair System Description: Same
Maintenance Agreement Required: ☐ Yes ☒ No

☒ House/Mod. Home No. Bedrooms 4
☐ Mobile Home No. Bathrooms 3½
☐ Business No. Employees
☐ Other


☐ Slab ☒ Crawl Space ☐ Basement w/plumbing ☐ Basement wo/plumbing

Water Supply: ☒ Individual ☐ Public ☐ Community


Comments:/Conditions:
1"=100'

Comments:/Conditions:

INITIAL SITE SKETCH

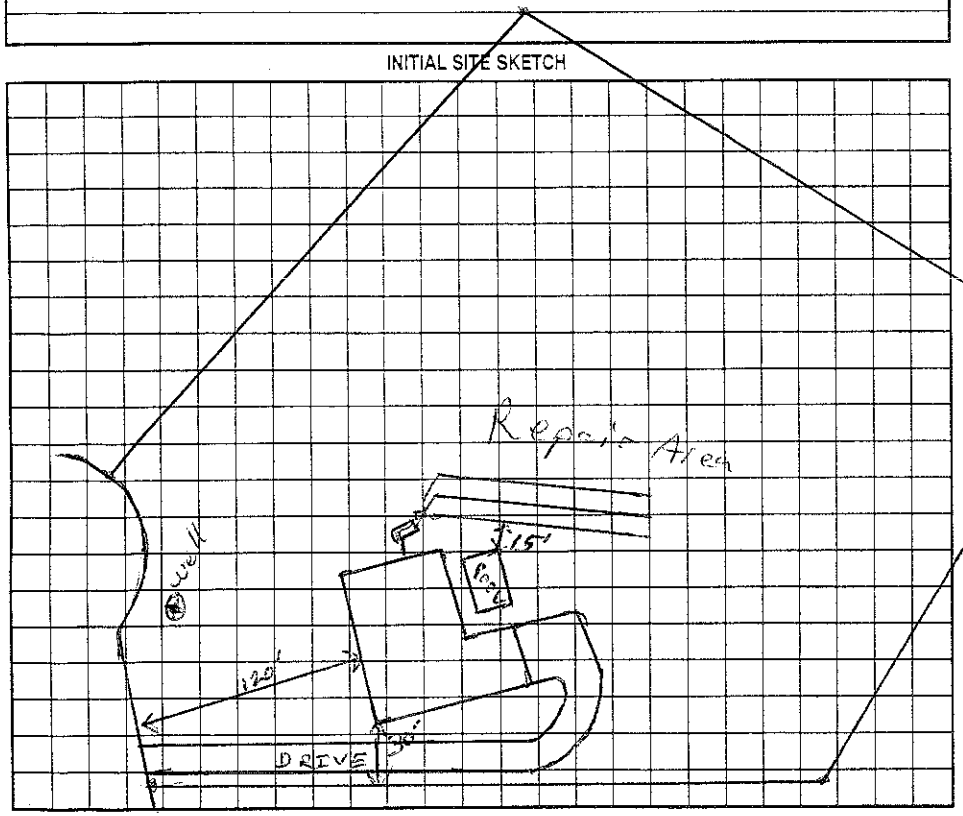

AS BUILT SKETCH

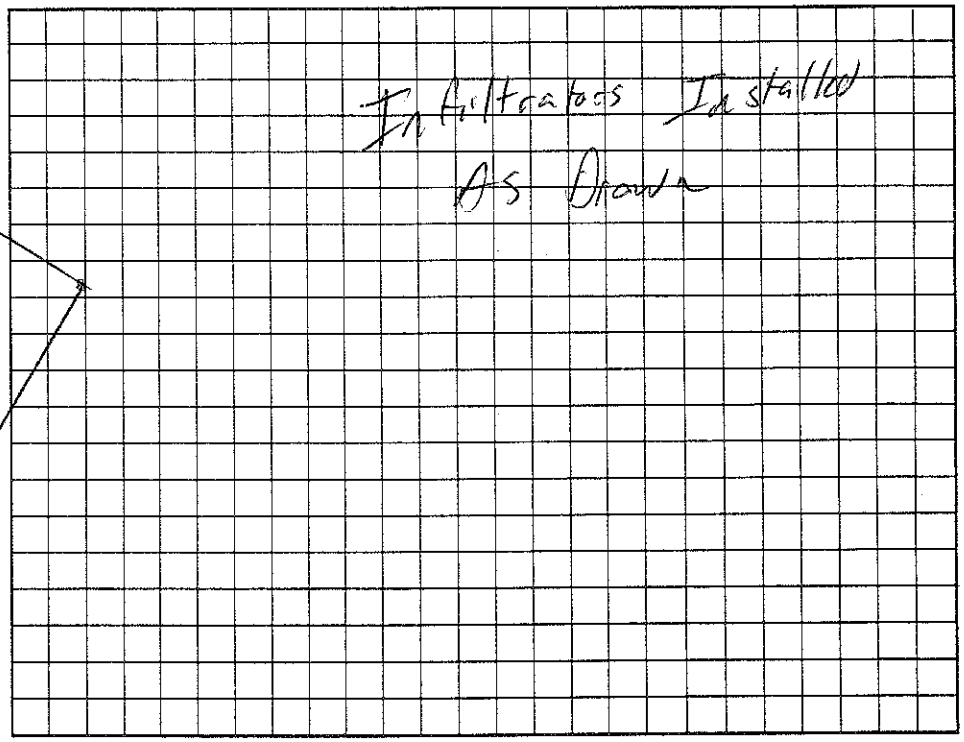

Permit can be suspended or revoked if any false information is supplied toward securing the permit/any unauthorized changes are made to the site/any unauthorized changes are made in the installation of the system. Improvement Permit with plat valid without expiration. Improvement Permit with site plan valid for sixty months. Authorization to Construct is valid for a period equal to that of Improvement Permit – not to exceed sixty months.

Signed: date 10/9/03 Installed by: F J Ervin

Improvement Permit by: RS date 10/6/03 Operation Permit by: AS date 3/11/04

Authorization to Construct by: RS date 10/6/03 Existing System Inspection by: date

HEALTH DEPT. COPY: WHITE OWNER COPY (FINAL): YELLOW OWNER COPY (INITIAL): PINK