IREDELL COUNTY HEALTH DEPARTMENT

STATESVILLE 704-878-5305 MOORESVILLE 704-664-5281

PIN# 4655-36-2435

IMPROVEMENT PERMIT / CERTIFICATE OF COMPLETION / OPERATION PERMIT / EXISTING SYSTEM INSPECTION

PROPERTY DESCRIPTION NO. 18714 DATE 9/6/94 TAX MAP NO. 2114-14-A-4,5,14) Watershed: ☐ Yes ☑ No

OWNER OR CONTRACTOR Ray Cook PHONE: Business _____ Home 664-7013

ADDRESS Rt 7 Box 768-A Mooresville, NC. 28115

LOCATION Faith Rd. TR Live Oak Rd. corner lot on (R)

SUBDIVISION LG Caldwell LE BLOCK / SECTION _____ LOT 4,5,14 LOT AREA 26.8 Ac. SITE CLASS. P. DESIGN FLOW 480 L.T.A.R. (1) . 0 . 25 AWS

Septic Tank: 1000-1250 Gallons; STB 99 Date 10/6/95

Pump Tank: _____ Gallons; PT _____ Date _____

Pump Make: _____ Model ~~3150~~ 1020 Serial No. AWS

Nitrification Field: No Fields 1 Square Feet 1440 Linear Feet ~~600~~ 900

No Lines 7 ~~5~~ Trench Width 36" Max Trench Bottom Depth 24" Gravel Depth 12"

☑ New System ☐ Repair System Type: I, (II), III, IV, V, VI

System Description: Conv - Drop Boxes

Repair System Description: _____

Maintenance Agreement Required: ☐ Yes ☑ No

☑ House/Mod. Home No. Bedrooms 4

☐ Mobile Home No. Bathrooms 3.5

☐ Business No. Employees ____

☐ Other _____


Water Supply: ☑ Individual ☐ Community ☐ Public

☐ Slab ☑ Crawl Space ☐ Basement w/plumbing ☐ Basement wo/plumbing


Comments: SHALLOW - 24" TRENCH BOTTOM - SLOPE TO DRAIN DRAINFIELD AREA - USE DIVERSION DITCHING AS SHOWN.

Comments: Well not in site 11/16/95

INITIAL SITE SKETCH

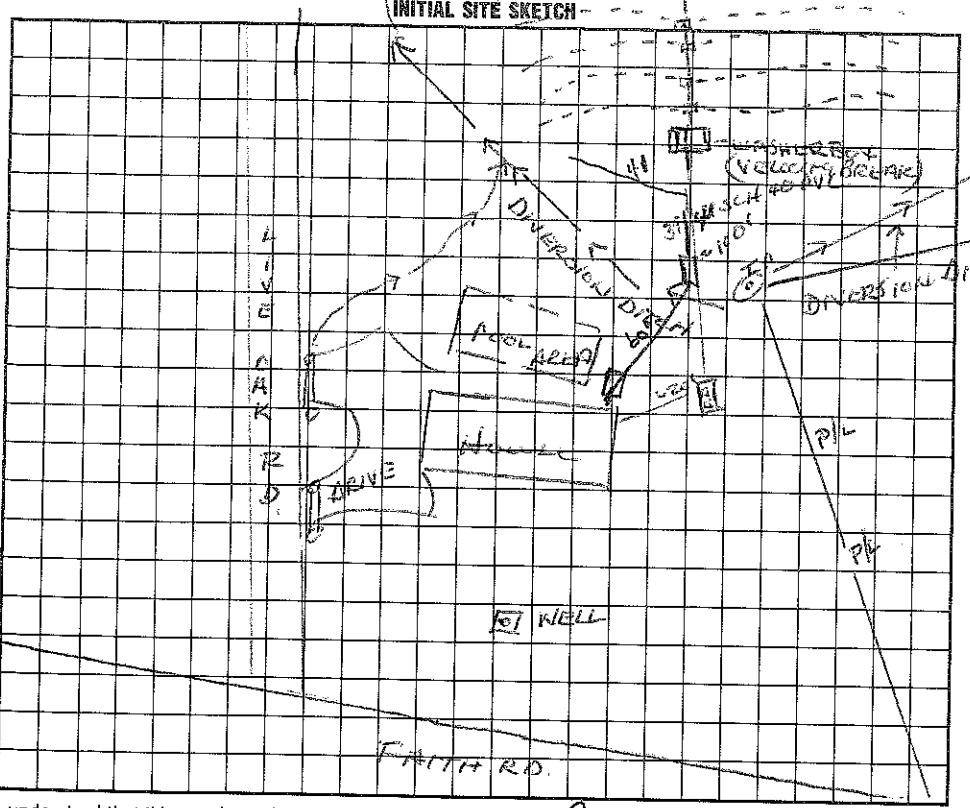

AS BUILT SKETCH

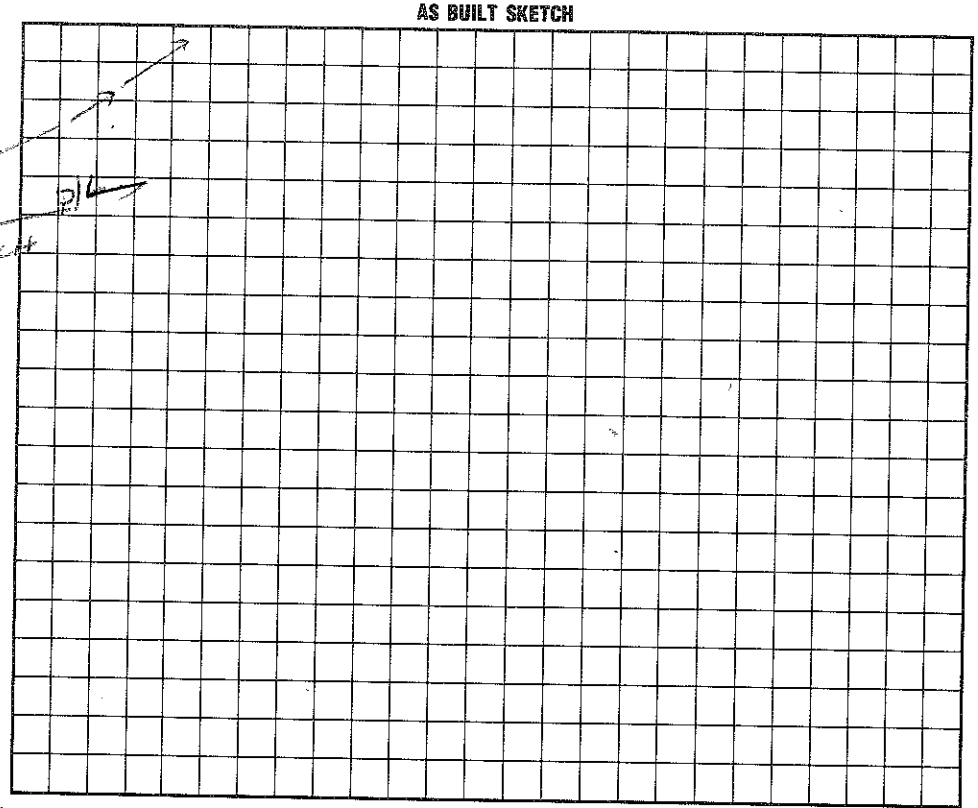

I understand that this permit can be suspended or revoked if any false information is supplied toward securing the permit/any unauthorized changes are made to the site/any unauthorized changes are made in the installation of the system. Improvement Permit is valid for 60 months from date of issuance.

Signed: Ray M. Cook

Improvement Permit by: Wesley Sparks RS date 9/6/94

Existing System Inspection by: _____ date _____

Installed by: Larry Tucker

Certificate of Completion by: Wesley Sparks RS. date 11/16/95

Operation Permit by: Wesley Sparks RS. date 11/16/95

HEALTH DEPT. COPY: WHITE INSPECTION COPY (FINAL): GREEN OWNER COPY (FINAL): YELLOW INSPECTION COPY (INITIAL): PINK OWNER COPY (INITIAL): GOLD