IREDELL COUNTY HEALTH DEPARTMENT

STATESVILLE 704-878-5305 130.00 Paid MOORESVILLE 704-664-5281 1:30

IMPROVEMENT PERMIT / AUTHORIZATION TO CONSTRUCT / OPERATION PERMIT / EXISTING SYSTEM INSPECTION

PERMIT# 118358 PIN# 4655 36 9326 DATE 2/24/04

OWNER OR CONTRACTOR Robbie Nelson PHONE: Business 704-664-5432 Home

ADDRESS 117 Black Rogers Ln. Mooresville, NC. 28115

LOCATION 115-21 S to Faith Rd. TL Jenny Marie, corner lot on E

SUBDIVISION Serene Lake BLOCK / SECTION LOT 1 LOT AREA ~1Ac SITE CLASS. PS DESIGN FLOW 360 L.T.A.R. .3

Septic Tank: 1000 Gallons; STB 825 Date 5/6/04
Pump Tank: Gallons; PT Date
Pump Make: Model Serial No.
Nitrification Field: No Fields 1 Square Feet 900 Linear Feet 300
No Lines 3@100 Trench Width 3' Max Trench Bottom Depth 3'

[X] New System [ ] Repair System Type: I, II, III, IV, V, VI
System Description: Conv - 25% Reduced 345
Repair System Description: Same Type
Maintenance Agreement Required: [ ] Yes [X] No


[X] House/Mod. Home No. Bedrooms 3
[ ] Mobile Home No. Bathrooms 2.5
[ ] Business No. Employees
[ ] Other
Gravel Depth No [ ] Slab [X] Crawl Space [ ] Basement w/plumbing [ ] Basement wo/plumbing

Water Supply: [X] Individual [ ] Public [ ] Community

Comments:/Conditions:


INITIAL SITE SKETCH

1" = 50'

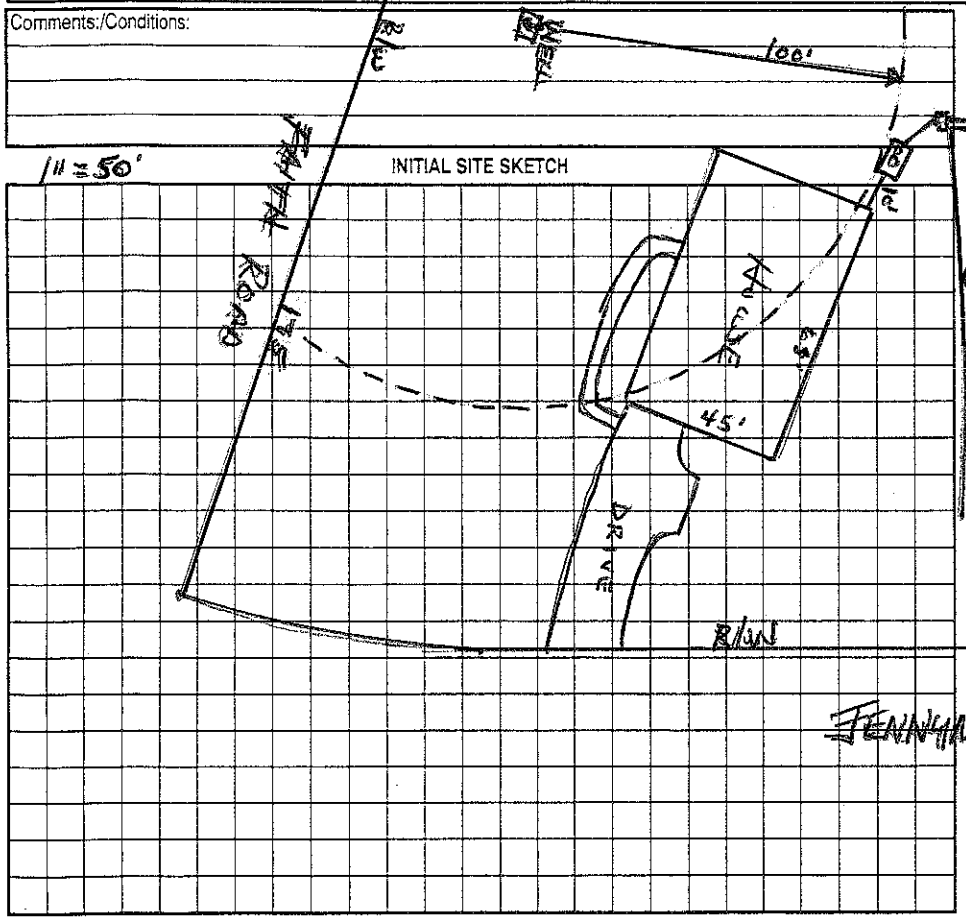

Comments:/Conditions: Infiltrator installed

AS BUILT SKETCH

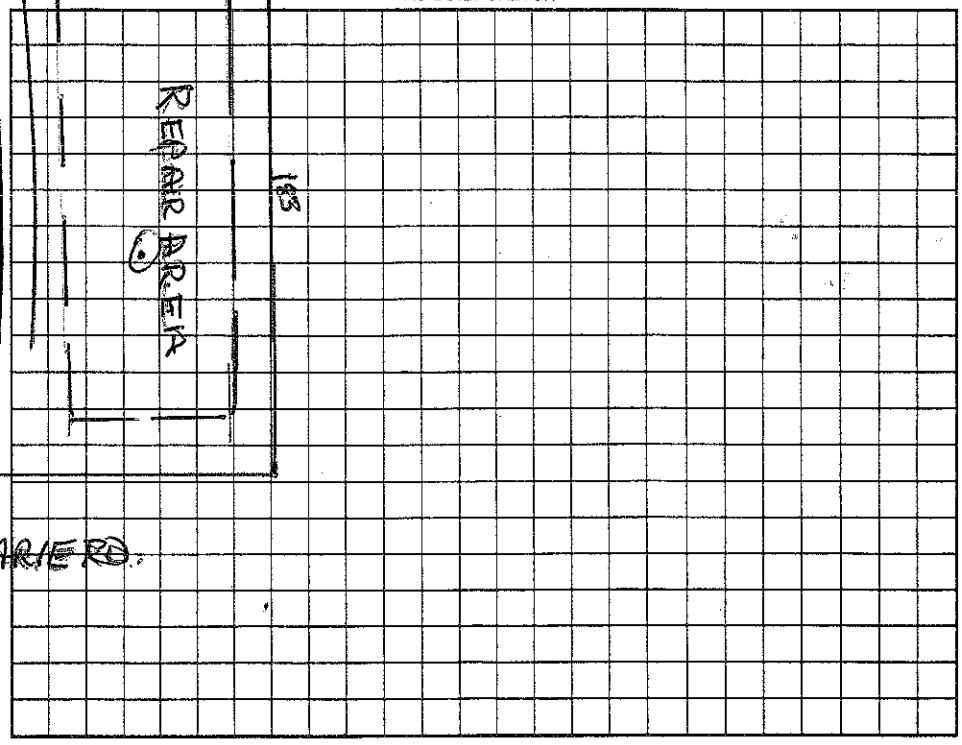

Permit can be suspended or revoked if any false information is supplied toward securing the permit/any unauthorized changes are made to the site/any unauthorized changes are made in the installation of the system. Improvement Permit with plat valid without expiration. Improvement Permit with site plan valid for sixty months. Authorization to Construct is valid for a period equal to that of Improvement Permit – not to exceed sixty months.

Signed: * Robbie Nelson date 2-24-04

Improvement Permit by: Wesley Sparks R.S. date 2/24/04

Authorization to Construct by: Wesley Sparks R.S. date 2/24/04

Installed by: Rowen Septic Tank

Operation Permit by: Wesley Sparks R.S. date 6/25/04

Existing System Inspection by: date

HEALTH DEPT. COPY: WHITE OWNER COPY (FINAL): YELLOW OWNER COPY (INITIAL): PINK