ICHD - ENVIRONMENTAL HEALTH DIVISION

Statesville Office (704) 878-5305 x3456 | Mooresville Office (704) 660-3625 ST

PERMIT : OSWP 2024-505716

SEPTIC: IMPROVEMENT PERMIT / AUTHORIZATION TO CONSTRUCT / OPERATION PERMIT / EXISTING SYSTEM

PIN # 4665 -- 37 -- 2042

APPLICANT/OWNER: Jenna Whitt | APPLICANT ADDRESS: 231 Faith Rd, Mooresville

SITE ADDRESS: 231 Faith Rd, Mooresville 28115 | PHONE: 828-838-5705 | ALT. PHONE -

SITE DIRECTIONS: Mecklenburg Hwy - Faith | SAP CONTROLLED: ☐ YES ☐ NO

SUBDIVISION: - | SECTION: - | LOT # - | LOT AREA: 2.59 | DESIGN FLOW: Ex | L.T.A.R.(Initial): Ex | L.T.A.R (Repair): Ex

Septic Tank	1000 (gal)	STB	InAltrator	Date			
Pump Tank	(gal)	PT		Date			
Pump Make		Model		Serial #			
# Nitrification Fields	1	# Lines	2	Linear Ft	Ex		
Trench Width	Ex	*Max. Trench Depth(Initial)	Ex	*Max. Trench Depth(Repair)	Ex	Gravel Depth	-

* Measured on the downhill side of the trench

☐ New System ☒ Repair ☐ Expansion | System Type: I (II) III IV V VI

System Description: -

Repair System Description: Tank Replacement

Maintenance Agreement Required: ☐ YES ☒ NO

☒ GRAVITY ☐ PRESSURE

Effluent Standard: ☒ DSE ☐ HSE ☐ TS-I ☐ TS-II ☐ RCW ☐ NSF/ANSI 40

Usable Depth to LC (Initial): Ex | Usable Depth to LC (Repair): Ex

☒ Residence ☐ Business ☐ Other ☐ Slab ☐ Basement w/plumbing


No. Bedrooms: Ex | No. Persons: Ex | No. Employees: | ☒ Crawl Space | ☐ Basement w/o plumbing

Water Supply: ☒ Private ☐ Public ☐ Community

Limiting Condition

Comments / Conditions: Pump, crush, & fill old septic tank. Replace distribution if necessary.


INITIAL SITE SKETCH

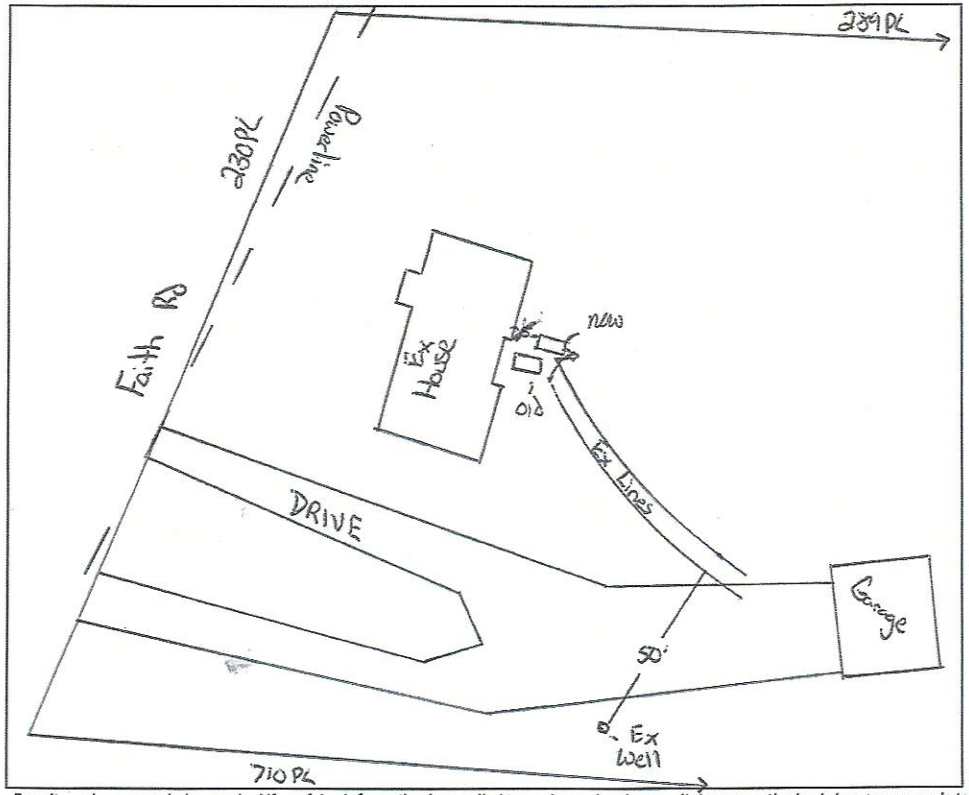

AS BUILT SKETCH

FOR SEPTIC FINAL INSPECTION CALL: 704-664-3703 between 8am-9am

the day the inspection is needed. Be sure to speak with an inspector to confirm your time.

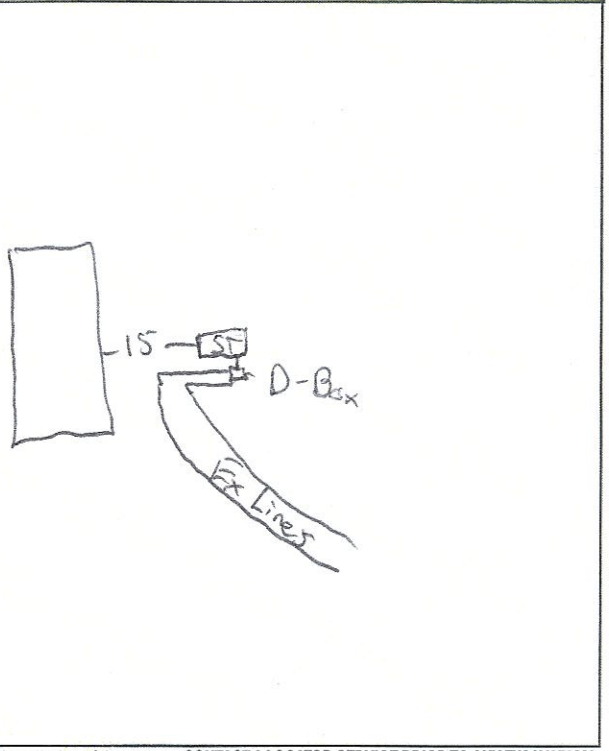

Permit can be suspended or revoked if any false information is supplied toward securing the permit / any unauthorized changes are made to the site / any unauthorized changes are made in the installation of the system. **CONTACT A LOCATOR SERVICE PRIOR TO ANY EXCAVATION**

☐ **IMPROVEMENT PERMIT** *with plat valid without expiration.* ☒ **IMPROVEMENT PERMIT** *with site plan valid for 60 mos.* ☒ **AUTHORIZATION TO CONSTRUCT** *valid for period equal to IMPROVEMENT PERMIT--not to exceed 60 mo.*

Owner / Applicant Signature: Online Signature | Date: | Installed by: Carolina Septic Pros

IMPROVEMENT PERMIT by: Cory Whit | Date: | OPERATION PERMIT by: Cory Whit | Date: 4/19/24

AUTHORIZATION TO CONSTRUCT by: Cory Whit | Date: | Existing System Inspected by: | Date: