4055426462

IREDELL COUNTY HEALTH DEPARTMENT

STATESVILLE 704-878-5305 MOORESVILLE 704-664-5281

IMPROVEMENT PERMIT / AUTHORIZATION TO CONSTRUCT / OPERATION PERMIT / EXISTING SYSTEM INSPECTION

PERMIT# 094045 PIN# ~~4655 42 9283~~ DATE 2/12/01

OWNER OR CONTRACTOR Mark Hager PHONE: Business 896-0013 Home

ADDRESS 169 Nance Farm Rd. Mooresville

LOCATION 1155 TL Midway Lek Rd. (L) Nance Farm Rd. last drive on (R) to end

SUBDIVISION N/A BLOCK / SECTION LOT LOT AREA 2.0 AC SITE CLASS. PS DESIGN FLOW 480 L.T.A.R. .3

Septic Tank: 1000 Gallons: STB 794 Date 10/9/01
Pump Tank: Gallons; PT Date
Pump Make: Model Serial No.
Nitrification Field: No Fields 1 Square Feet 1600 Linear Feet 532
No Lines 4 @ 133' Trench Width 3' Max Trench Bottom Depth 3' Gravel Depth 12"

[X] New System [ ] Repair System Type: I (II) III, IV, V, VI
System Description: Gravity-Conventional
Repair System Description:
Maintenance Agreement Required: [ ] Yes [X] No

[X] House/Mod. Home No. Bedrooms 4
[ ] Mobile Home No. Bathrooms 4
[ ] Business No. Employees
[ ] Other


[ ] Slab [X] Crawl Space [ ] Basement w/plumbing [ ] Basement wo/plumbing

Water Supply: [X] Individual [ ] Public [ ] Community


Comments:/Conditions:

Comments:/Conditions:

INITIAL SITE SKETCH

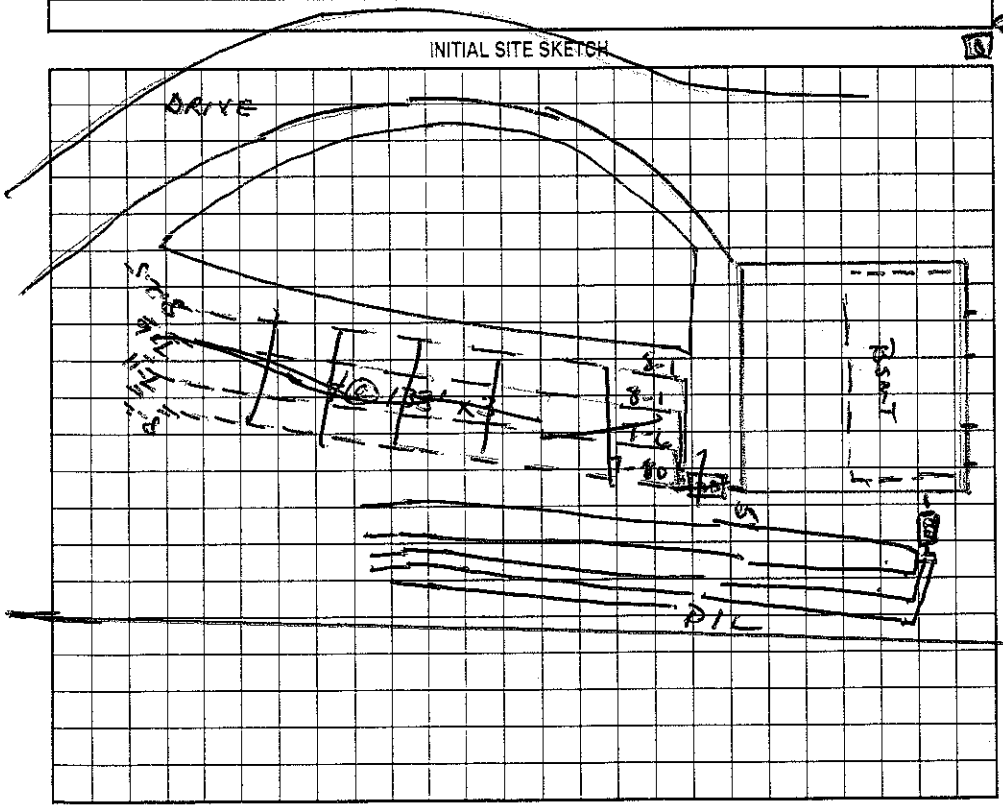

AS BUILT SKETCH

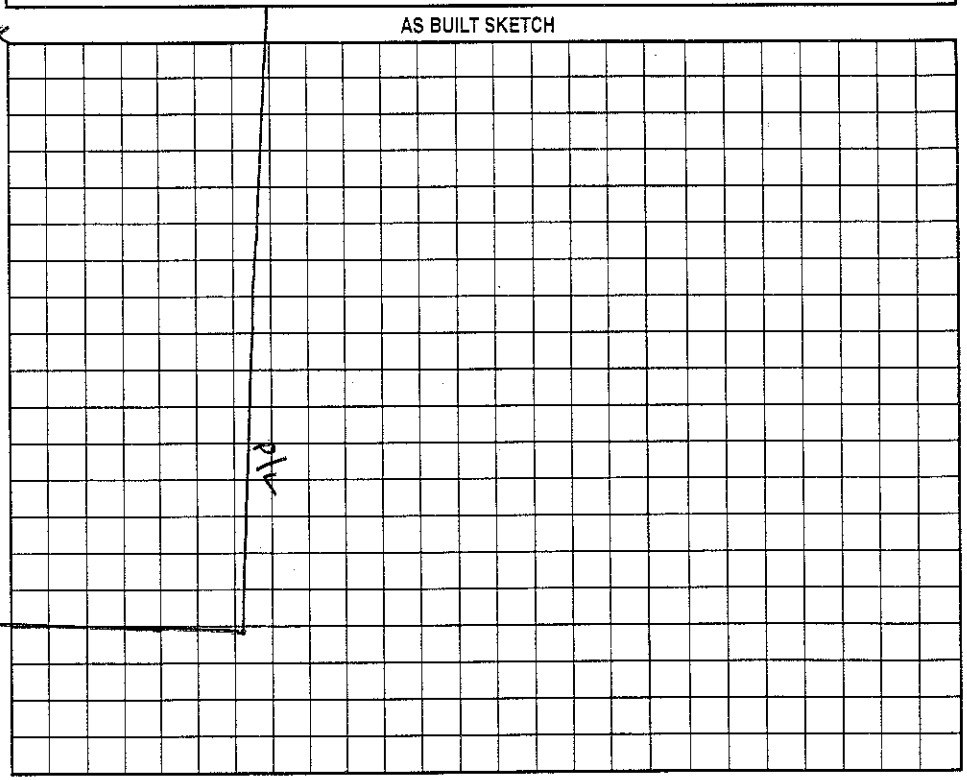

Permit can be suspended or revoked if any false information is supplied toward securing the permit/any unauthorized changes are made to the site/any unauthorized changes are made in the installation of the system. Improvement Permit with plat valid without expiration. Improvement Permit with site plan valid for sixty months. Authorization to Construct is valid for a period equal to that of Improvement Permit – not to exceed sixty months.

Signed: * Mark Hager date 4-3-01 Installed by: FJ Erwin

Improvement Permit by: Wesley Sparks RS. date 2/12/01 Operation Permit by: Wesley Sparks RS. date 11/27/01

Authorization to Construct by: Wesley Sparks RS. date 2/12/01 Existing System Inspection by: date

HEALTH DEPT. COPY: WHITE OWNER COPY (FINAL): YELLOW OWNER COPY (INITIAL): PINK