IREDELL COUNTY HEALTH DEPARTMENT - *ENVIRONMENTAL HEALTH* ☐ STATESVILLE OFFICE 704-878-5305 ☒ MOORESVILLE OFFICE 704-664-5281

IMPROVEMENT PERMIT / AUTHORIZATION TO CONSTRUCT / OPERATION PERMIT / EXISTING SYSTEM INSPECTION

PERMIT # 169463 PIN # 4655-43-1944 DATE 11-30-11

OWNER William Schnars APPLICANT: Same PHONE: Home/Cell # 704-249-7871 Business #

SITE ADDRESS 287 East Port Ln 28115 OWNER / APPLICANT ADDRESS Po Box 3141 28117

SITE DIRECTIONS 115 S, L East Port, L End

SUBDIVISION Yandle Acres BLOCK / SECTION LOT # 5 LOT AREA 1.002 Ac DESIGN FLOW 360 GAL/DAY T.A.R. .3

Septic Tank 1000 Gallons: STB Date

Pump Tank Gallons: P T Date

Pump Make Model Serial #

No. Nitrification Fields: 1 No. Lines 3 Linear Feet 300'

Trench Width 36" Max. Trench Bottom Depth 36" Gravel Depth —

☒ New System ☐ Repair ☐ Expansion System Type I II (III) IV V VI

System Description: G-25%

Repair System Description: Same

Maintenance Agreement Required ☐ YES ☒ NO

☒ GRAVITY ☐ PRESSURE

☒ Residence No. Bedrooms 3

☐ Business No. Persons

☐ Other No. Employees

☐ Slab ☒ Crawl Space


☐ Basement w/plumbing ☐ Basement w/o plumbing

Water Supply: ☒ Private ☐ Public ☐ Community


Comments / Conditions: ① Shave Berme In System Area

* Has 81.80 To Go To Well Permit

INITIAL SITE SKETCH

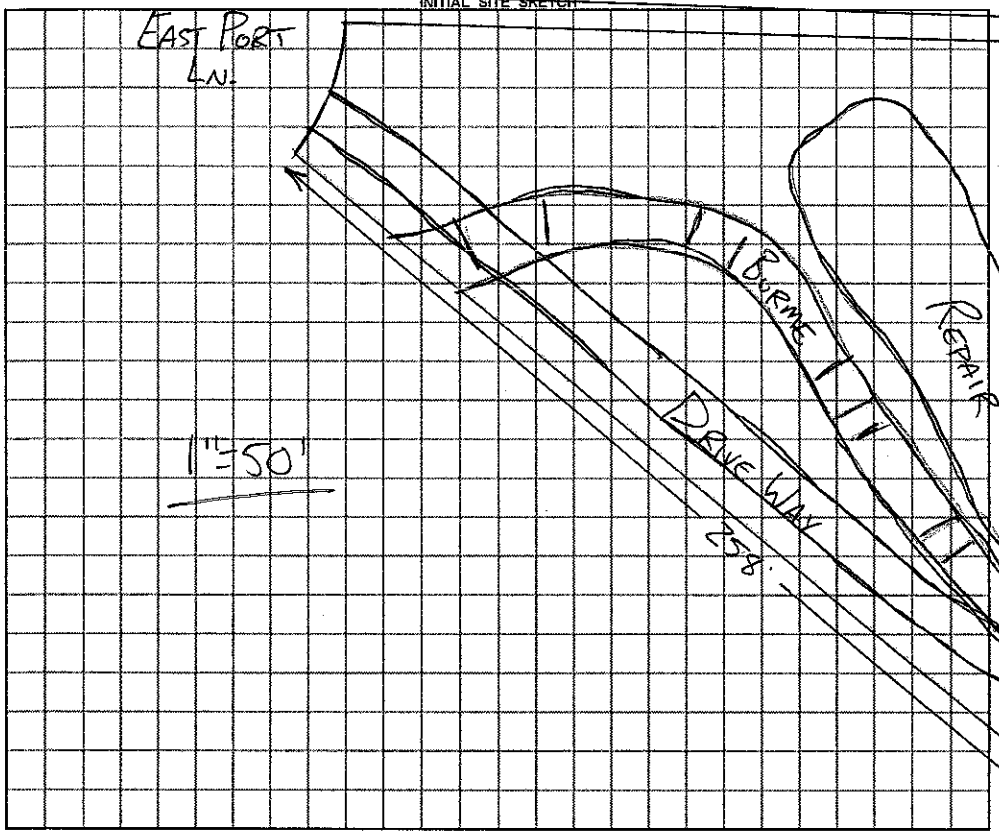

AS BUILT SKETCH

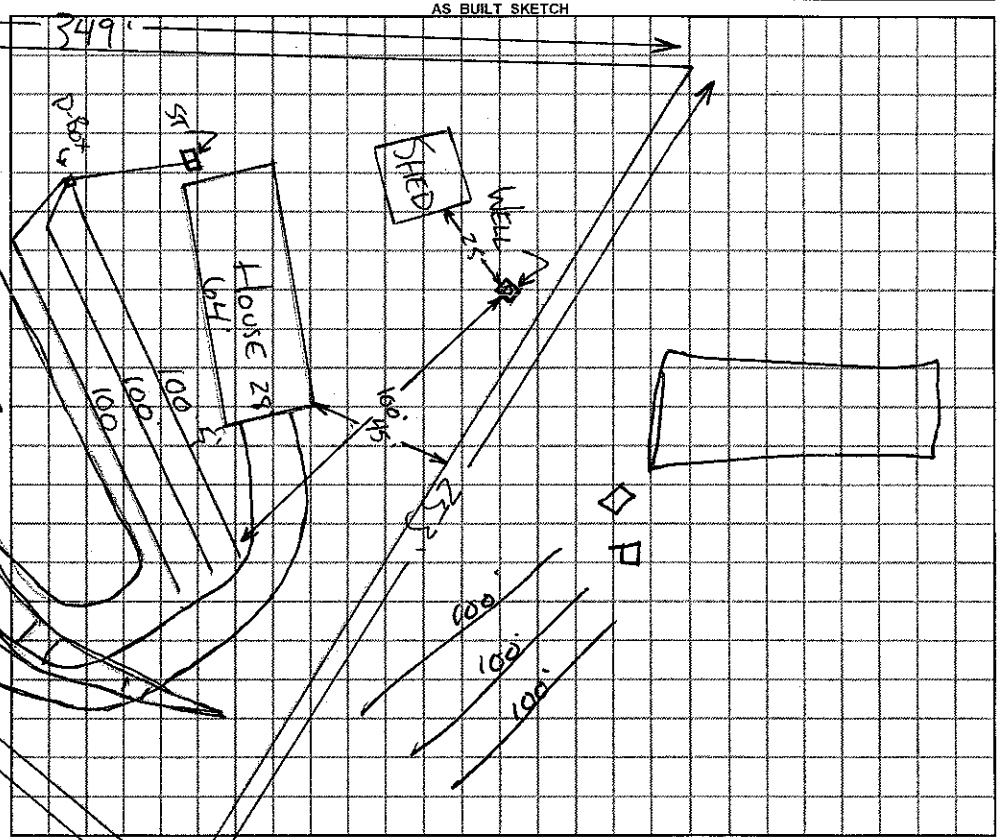

Permit can be suspended or revoked if any false information is supplied toward securing the permit / any unauthorized changes are made to the site / any unauthorized changes are made in the installation of the system.

☐ ***IMPROVEMENT PERMIT*** with plat valid without expiration. ☒ ***IMPROVEMENT PERMIT*** with ~~plat valid without expiration.~~ site plan valid 60 mo. ☐ ***AUTHORIZATION TO CONSTRUCT*** valid for period equal to IMPROVEMENT PERMIT–not to exceed 60 mo.

Owner / Applicant Signature: William T Schnars Date 12/1/11

IMPROVEMENT PERMIT by: REHS Date 11-30-11

AUTHORIZATION TO CONSTRUCT by: REHS Date 12-1-11

Installed by: McDaniel Grading

OPERATION PERMIT by: REHS Date 1-20-12

Existing System Inspected by: REHS Date

YOU SHOULD CONTACT A LOCATOR SERVICE PRIOR TO ANY EXCAVATION

White Copy – Environmental Health YELLOW COPY (Final) Owner / Applicant PINK COPY (Initial) Owner / Applicant

IREDELL COUNTY HEALTH DEPARTMENT

STATESVILLE 704-878-5305 MOORESVILLE 704-664-5281

IMPROVEMENT PERMIT / AUTHORIZATION TO CONSTRUCT / OPERATION PERMIT / EXISTING SYSTEM INSPECTION

PERMIT# 12734 D PIN# 4655 43 1944 DATE 4/19/05

OWNER OR CONTRACTOR Arthur Channel PHONE: Business 704-658-1363 Home

ADDRESS 698 Rebecca Jane Dr. Mooresville, NC. 28115

LOCATION 115 S, TL Westport TR to end on R of cul de sac

SUBDIVISION Yandle Rues BLOCK / SECTION LOT 5 LOT AREA 1.002 SITE CLASS. PS DESIGN FLOW 360 L.T.A.R. .3

Septic Tank: 1000 Gallons; STB Date

Pump Tank: Gallons; PT Date

Pump Make: Model Serial No.

Nitrification Field: No Fields 1 Square Feet 900 Linear Feet 300

No Lines 3 @ 100' Trench Width 3' Max Trench Bottom Depth 3' Gravel Depth No

☒ New System ☐ Repair System Type: I, II, (III), IV, V, VI

System Description: Gravity - 25% Reduced

Repair System Description: 16" PPBPS

Maintenance Agreement Required: ☐ Yes ☒ No

☒ House/Mod. Home No. Bedrooms 3

☐ Mobile Home No. Bathrooms 3

☐ Business No. Employees

☐ Other


☐ Slab ☐ Crawl Space ☐ Basement w/plumbing ☐ Basement wo/plumbing

Water Supply: ☒ Individual ☐ Public ☐ Community


Comments:/Conditions: Shape berm to help installation of this system. (1" = 50')

Comments:/Conditions:

INITIAL SITE SKETCH

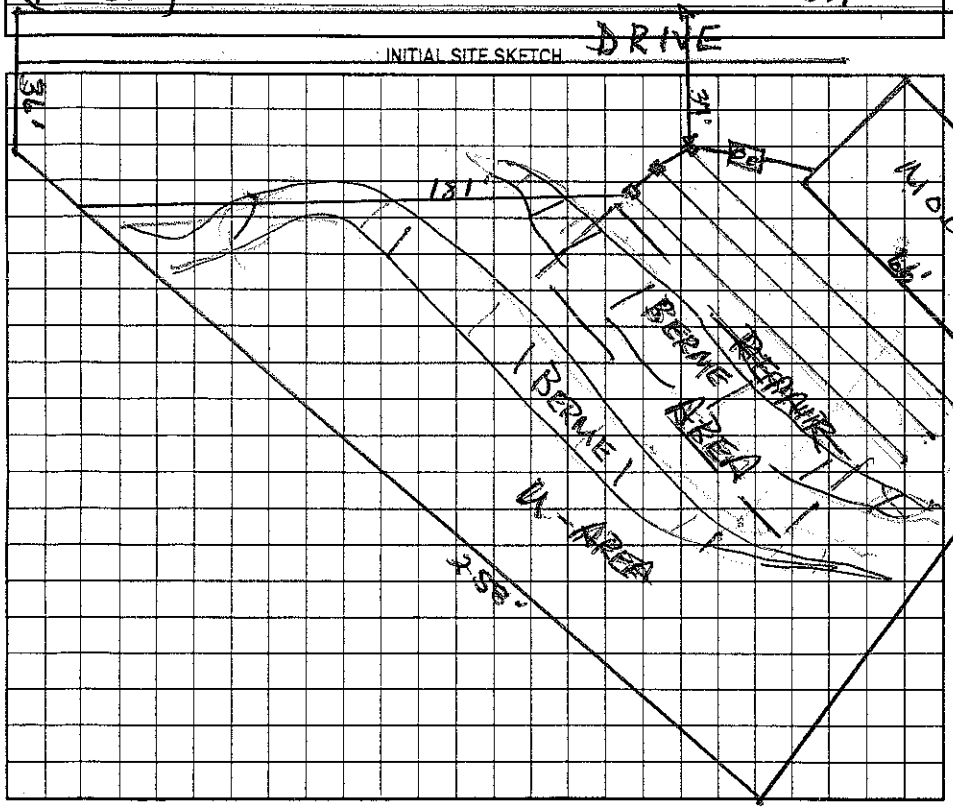

AS BUILT SKETCH

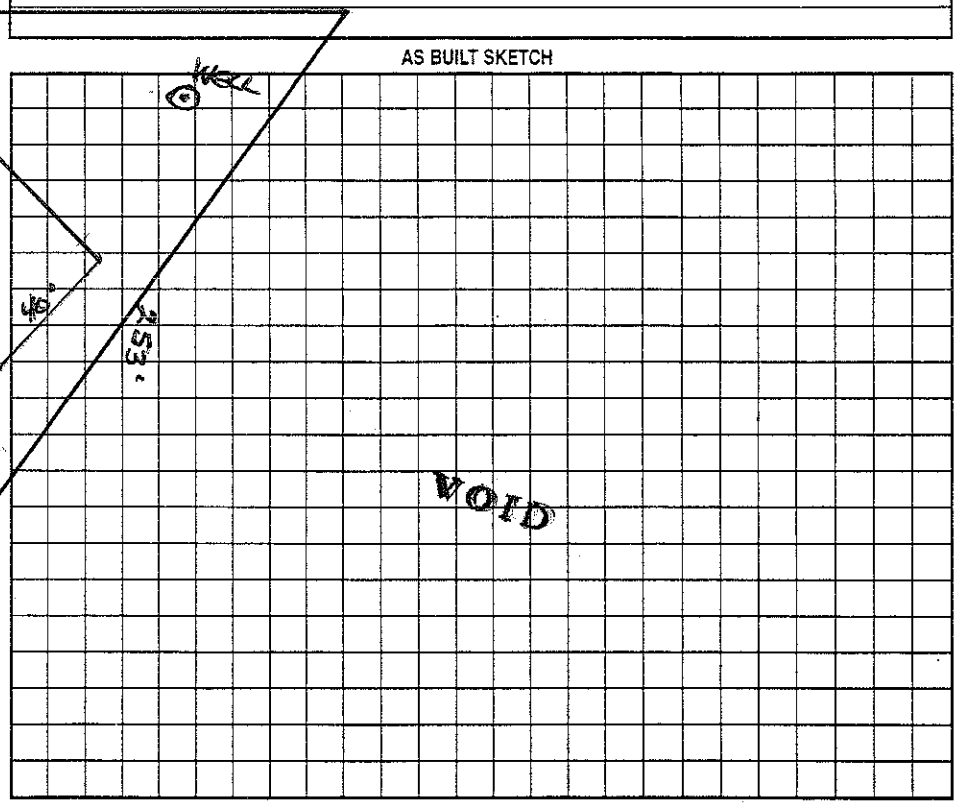

Permit can be suspended or revoked if any false information is supplied toward securing the permit/any unauthorized changes are made to the site/any unauthorized changes are made in the installation of the system. Improvement Permit with plat valid without expiration. Improvement Permit with site plan valid for sixty months. Authorization to Construct is valid for a period equal to that of Improvement Permit – not to exceed sixty months.

Signed: VOID date 4/20/05 Installed by:

Improvement Permit by: Wesley Sparks RS. date 4/19/05 Operation Permit by: VOID date

Authorization to Construct by: Wesley Sparks RS date 4/19/05 Existing System Inspection by: date

HEALTH DEPT. COPY: WHITE OWNER COPY (FINAL): YELLOW OWNER COPY (INITIAL): PINK