Authorization to Const. 4655443604

IREDELL COUNTY HEALTH DEPARTMENT

STATESVILLE 704-878-5305 MOORESVILLE 704-664-5281

IMPROVEMENT PERMIT / ~~CERTIFICATE OF COMPLETION~~ / OPERATION PERMIT / EXISTING SYSTEM INSPECTION

PROPERTY DESCRIPTION NO. 23173 DATE 3/11/96 TAX MAP NO. ID-C-35A Watershed: ☐ Yes ☐ No

OWNER OR CONTRACTOR Joseph W. Fish PHONE: Business _____ Home 872-3104

ADDRESS P.O. Box 115 Mt. Mourne NC 28123

LOCATION 115S - TL Faith Rd - TR Midway Lk Rd. - TR Winedale Rd - property on right

SUBDIVISION _____ BLOCK / SECTION _____ LOT _____ LOT AREA 637X643X291' SITE CLASS. PS DESIGN FLOW 240 gpd L.T.A.R. .3 gpd/sf

Septic Tank: 1000 Gallons; STB ~~12/7/95~~ Typical 12/7/95

Pump Tank: _____ Gallons; PT _____ Date _____

Pump Make: _____ Model _____ Serial No. _____

Nitrification Field: No Fields 1 Square Feet 800 Linear Feet 270

No Lines 3 Trench Width 36" Max Trench Bottom Depth 36" Gravel Depth 12"

☑ New System ☐ Repair System Type: I, II, III, IV, V, VI

System Description: Gravity Conventional

Repair System Description: same

Maintenance Agreement Required: ☐ Yes ☑ No

☐ House/Mod. Home No. Bedrooms 3

☑ Mobile Home No. Bathrooms 2

☐ Business No. Employees _____

☐ Other _____

☐ Slab ☑ Crawl Space ☐ Basement w/plumbing ☐ Basement wo/plumbing


Water Supply: ☑ Individual ☐ Community ☐ Public Neighbors well

Comments:

Comments:

637'

INITIAL SITE SKETCH

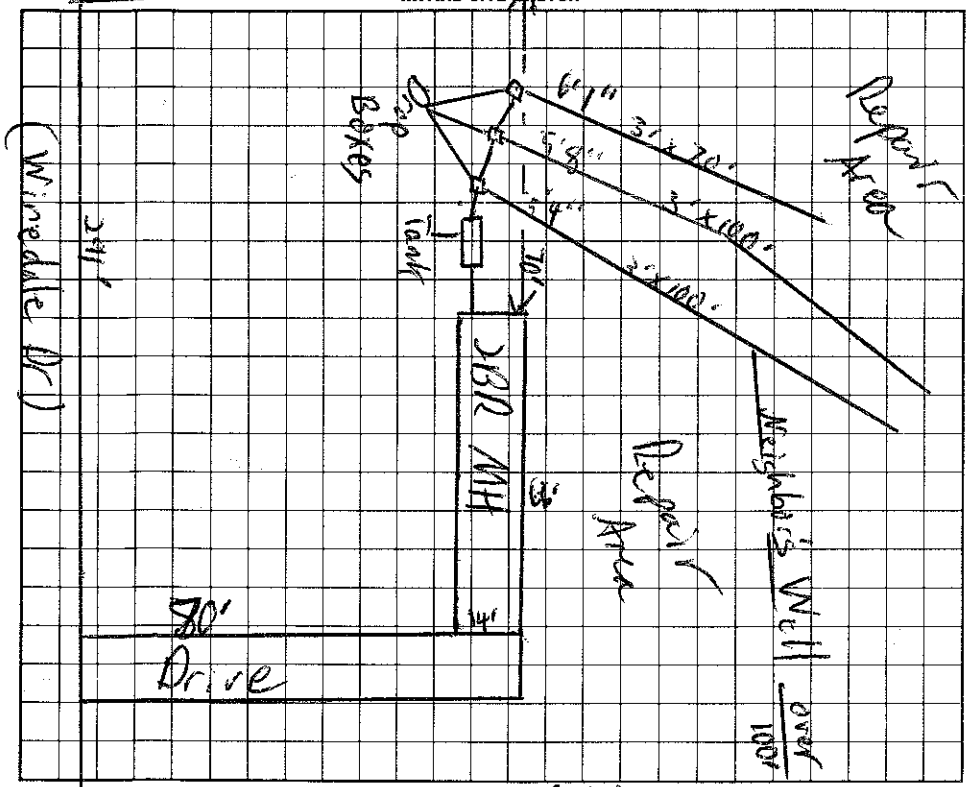

AS BUILT SKETCH

I understand that this permit can be suspended or revoked if any false information is supplied toward securing the permit/any unauthorized changes are made to the site/any unauthorized changes are made in the installation of the system.

Signed: X Joseph W Fish Installed by: FJ Ervin

Improvement Permit by: C. Bridgeman EHSS date 3/11/96

Existing System Inspection by: C. Bridgeman EHSS date 3/9/96

Certificate of Completion by: _____ date _____

Operation Permit by: C. Bridgeman date 3/27/96

HEALTH DEPT. COPY: WHITE INSPECTION COPY (FINAL): GREEN OWNER COPY (FINAL): YELLOW INSPECTION COPY (INITIAL): PINK OWNER COPY (INITIAL): GOLD

Authorization to Construct

Authorization to Construct is valid for 6 months from date issued. Issuance does not entitle