IREDELL COUNTY HEALTH DEPARTMENT

authorization to construct

STATESVILLE 704-878-5305 MOORESVILLE 704-664-5281

IMPROVEMENT PERMIT / ~~CERTIFICATE OF COMPLETION~~ / OPERATION PERMIT / EXISTING SYSTEM INSPECTION

PROPERTY DESCRIPTION NO. Repair DATE 4/9/96 TAX MAP NO. 4655443937 Watershed: ☐ Yes ☑ No

OWNER OR CONTRACTOR Peggy Sigmon PHONE: Business 892-8081 Home 892-1474

ADDRESS PO 490 4 Mt Mourne 28112 3

LOCATION Faith Rd - TR Midway Lake Rd - 2nd House on ~~left~~, RIGHT

SUBDIVISION _____ BLOCK / SECTION _____ LOT _____ LOT AREA 3 ac. SITE CLASS. PS DESIGN FLOW 360gpd E.T.A.R. .35 gpd/sq

Septic Tank: Existing / 1000 Gallons; STB _____ Date _____

Pump Tank: _____ Gallons; PT _____ Date _____

Pump Make: _____ Model _____ Serial No. _____

Nitrification Field: No Fields 1 Square Feet 900 Linear Feet 300

No Lines 3 Trench Width 36" Max Trench Bottom Depth 36" Gravel Depth 12"

☐ New System ☑ Repair System Type: I II III IV V VI

System Description: Gravity Conv.

Repair System Description: _____

Maintenance Agreement Required: ☐ Yes ☑ No

☐ House/Mod. Home No. Bedrooms 3

☐ Mobile Home No. Bathrooms 2

☐ Business No. Employees ____

☐ Other _____


☐ Slab ☑ Crawl Space ☐ Basement w/plumbing ☐ Basement wo/plumbing

Water Supply: ☑ Individual ☐ Community ☐ Public


Comments: Keep 50' from well with any part of system. Do not tie into old system.

Comments:

INITIAL SITE SKETCH

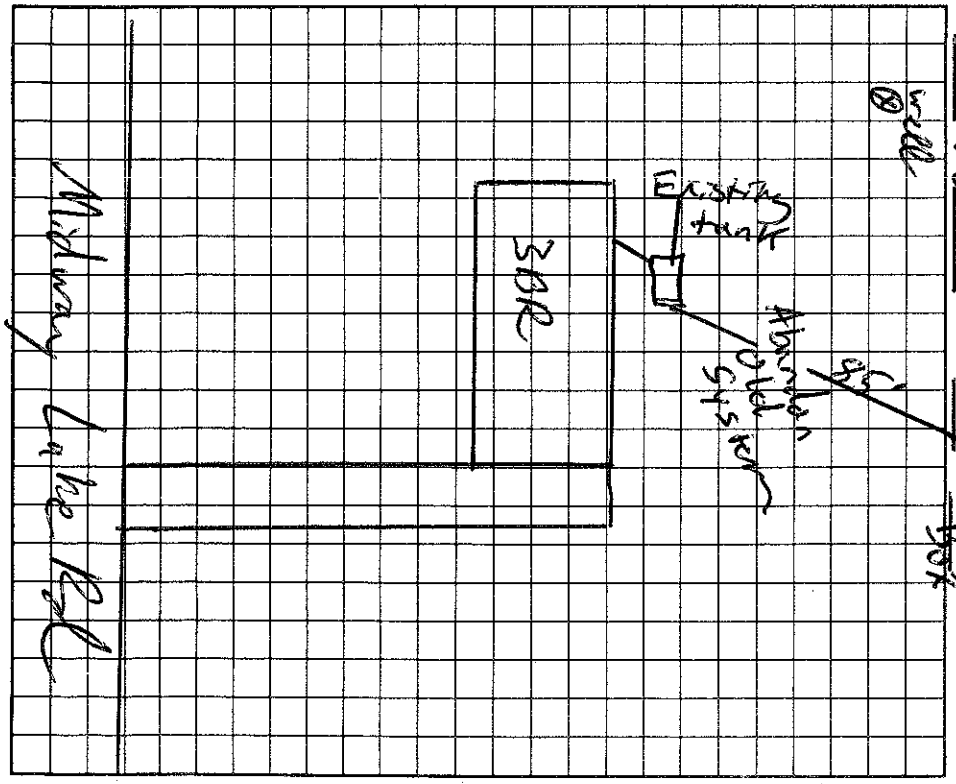

AS BUILT SKETCH

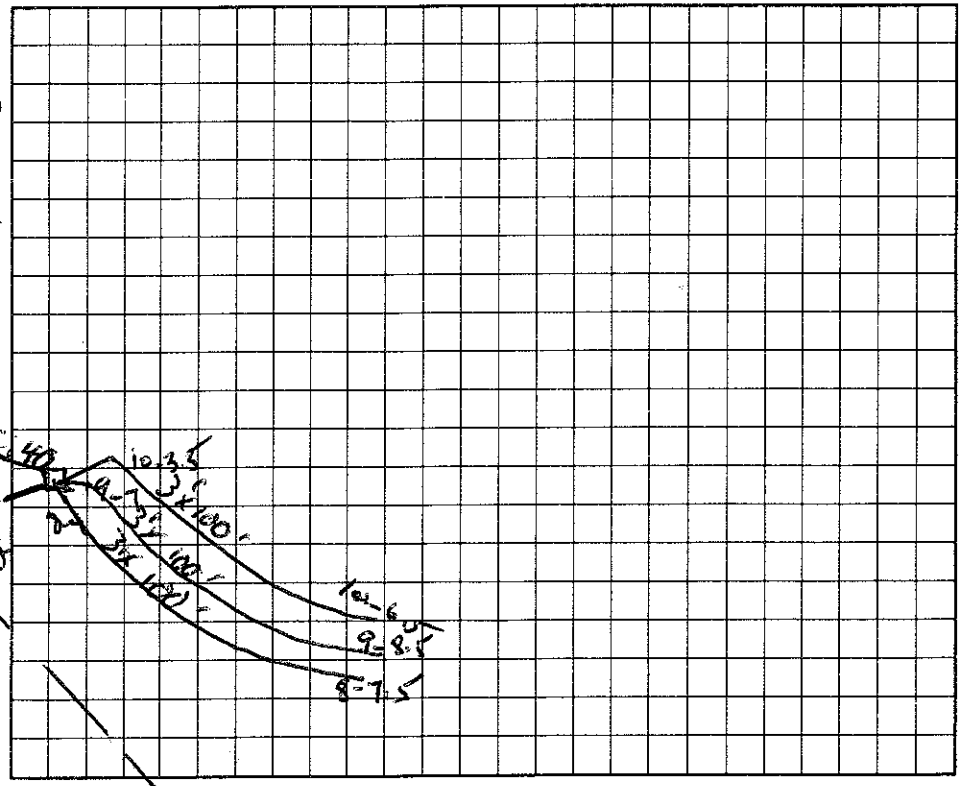

I understand that this permit can be suspended or revoked if any false information is supplied toward securing the permit/any unauthorized changes are made to the site/any unauthorized changes are made in the installation of the system.

Signed: ~~X~~ Ray Sigmon

Improvement Permit by: ~~Bob Tatum EHSS~~ date 4/9/96

Authorization to Construct Existing System Inspection by: ~~Bob Tatum EHSS~~ date 4/9/96

Installed by: Julian Bowles

Certificate of Completion by: _____ date _____

Operation Permit by: Wesley Sparks R.S. date 7/17/96

HEALTH DEPT. COPY: WHITE INSPECTION COPY (FINAL): GREEN OWNER COPY (FINAL): YELLOW INSPECTION COPY (INITIAL): PINK OWNER COPY (INITIAL): GOLD