9.30

IREDELL COUNTY HEALTH DEPARTMENT

STATESVILLE 704-878-5305 MOORESVILLE 704-664-5281

IMPROVEMENT PERMIT / AUTHORIZATION TO CONSTRUCT / OPERATION PERMIT / EXISTING SYSTEM INSPECTION

PERMIT# 076420 PIN# 4655447408 DATE 10/1/98

OWNER OR CONTRACTOR David Shumaker PHONE: Business Home 892-6012

ADDRESS 115 Winedale Ln Mooresville, NC. 28115

LOCATION Hwy 115 S. to Faith Rd TR Midway Lake Rd 1/2 Mile on Right Small dirt Rd Winedale

SUBDIVISION BLOCK / SECTION LOT LOT AREA 1.85 Acre SITE CLASS. PS DESIGN FLOW 360gpd L.T.A.R. .3

Septic Tank: 1000 Gallons; STB 1012 Date 10/15/98

Pump Tank: Gallons; PT Date

Pump Make: Model Serial No.

Nitrification Field: No Fields 1 Square Feet 1200' Linear Feet 400'

No Lines 4at 100' Trench Width 36" Max Trench Bottom Depth 18"-24" Gravel Depth 12"

☒ New System ☐ Repair System Type: I, II, III, IV, V, VI

System Description: Gravity - Conventional

Repair System Description: Same

Maintenance Agreement Required: ☐ Yes ☒ No

☒ House/Mod. Home No. Bedrooms 3

☐ Mobile Home No. Bathrooms 2

☐ Business No. Employees

☐ Other

☐ Slab ☒ Crawl Space ☐ Basement w/plumbing ☐ Basement wo/plumbing

Water Supply: ☒ Individual-Shared ☐ Public Next Door ☐ Community

Comments:/Conditions:


* Must Keep Septic System 100' from "Shared Well" & 50' from Single Home Well

Keep Septic System at least 10' from PL & 5' from House

Comments:/Conditions:

INITIAL SITE SKETCH

Scale 1:100

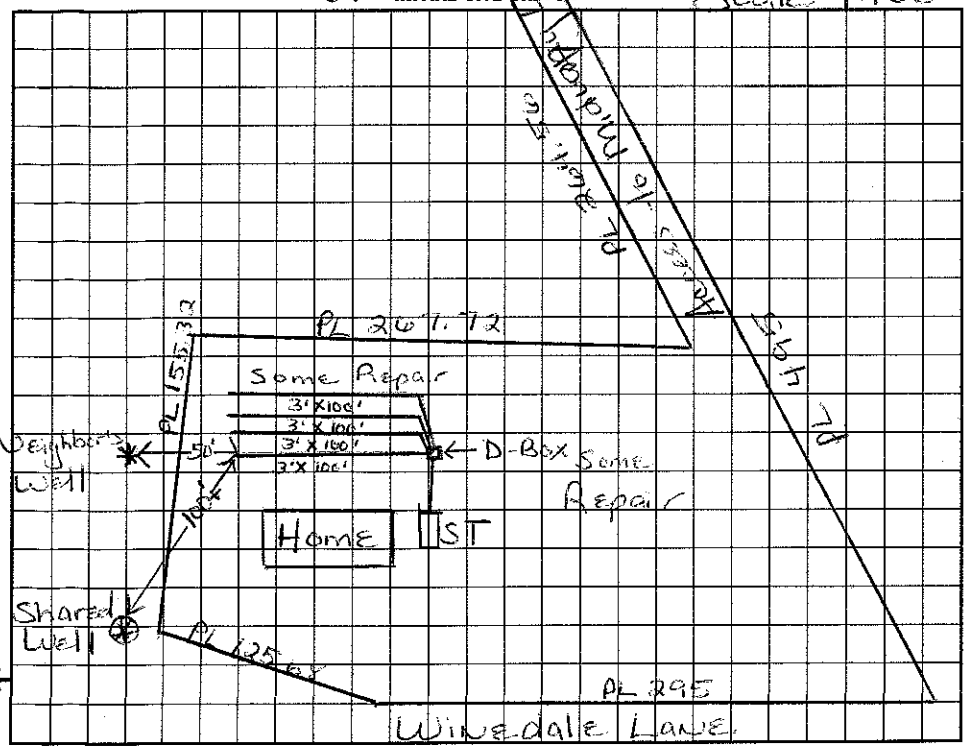

AS BUILT SKETCH

I understand that this permit can be suspended or revoked if any false information is supplied toward securing the permit/any unauthorized changes are made to the site/any unauthorized changes are made in the installation of the system. Improvement Permit with plat valid without expiration. Improvement Permit with site plan valid for sixty months. Authorization to Construct is valid for a period equal to that of Improvement Permit – not to exceed sixty months.

Signed: David Shumaker date 10-23-98

Improvement Permit by: Maria H. Watson date 10/1/98

Authorization to Construct by: Maria H. Watson date 10/1/98

Installed by: A-1 Backhoe

Operation Permit by: Maria H. Watson RS date 1/13/99

Existing System Inspection by: date

HEALTH DEPT. COPY: WHITE INSPECTION COPY (FINAL): GREEN OWNER COPY (FINAL): YELLOW INSPECTION COPY (INITIAL): PINK OWNER COPY (INITIAL): GOLD